

St. 211
 Pl. 317
 Ave. No. 317

Warren

Name of Owner
H. & F. Binch Inc.

Labor and Mat'l. Report Sept. 11 1961

51'7"
 60'2"
 #216
 Curb Box
 gate

10" Main Elev. of Main at tap 5'

Gate at • • Gate at

6" CI 36 1/2' to main

• Curb Box

This 6" TAP
 MEASURED FROM
 # 216 WARREN ST.

LSM-5C-3-10-61

St. WARREN ~~St.~~
 Ave. No. 217

Name of Owner
Native Textiles

Labor and Mat'l. Report July 25 1975

217 Warren
 Steps
 74'-10"
 80'-9"
 Curb Box

10" Main Elev. of Main at tap 6'

Gate at • • Gate at

6" CI 36' to main

10/22 - Not on map • Curb Box

New 6" Service
 out in far side of
 Warren St

LSM-5C-6-1-67
10" X 6" TAPPING SLEEVE

LABOR AND MATERIALS

6" Copper } Connection *Mueller* \$ _____
 Lead }
 1 Curb } Cock-Valve } *10" x 6" in.* \$ _____
 T. S. & V. } *6" Tapping Valve*
 1 Service box { Short $3\frac{1}{2} \times 4\frac{1}{2}$ } \$ _____
 Old returned { Long $4\frac{1}{2} \times 5\frac{1}{2}$ } \$ _____
 { Buff or Rdway } \$ _____
 3 *6\frac{1}{2}* Ft. *6* in. { Copper } Pipe at \$ _____
 { G.I. }
 { C.I. }
 Nipples in. at \$ _____
 Bushings to in. at \$ _____
 Red'g }
 Inc'g } Coupl'gs to in. at \$ _____
 Union in. at \$ _____
 Meter in. at \$ _____
 Lead Joints at \$ _____
 Compound Joints at \$ _____
 Maintenance Foreman \$ _____
 Hrs. Water Maint. Man—1 at \$ _____
 Hrs. Water Maint. Man—2 at \$ _____
 Hrs. Garage Foreman at \$ _____
 Hrs. Labor— at \$ _____
 Hrs. Compressor at \$ _____
 Compensation Ins. at \$ _____ per C \$ _____
 Trucking \$ _____
 Pay't Patch \$ _____
 1- *18'-6" Length* \$ _____
 1- *12'-6" Piece* \$ _____
 1- *5'-6" Piece* \$ _____
 O'head \$ _____
 Tap by *m. Herx Co*
Oct. 9-11-1961.

LABOR AND MATERIALS

Tapping
 1 Copper } Connection *10" x 6" Sleeve* \$ _____
 Lead }
 Curb } Cock-Valve } *6" Valve*
 T. S. & V. }
 1 Service box { Short $3\frac{1}{2} \times 4\frac{1}{2}$ } \$ _____
 Old returned { Long $4\frac{1}{2} \times 5\frac{1}{2}$ } \$ _____
 { Buff or Rdway } \$ _____
 36 Ft. *6* in. { Copper } Pipe at *C.I. Pipe* \$ _____
 { C.I. }
 Nipples in. at \$ _____
 Bushings to in. at \$ _____
 Red'g }
 Inc'g } Coupl'gs to in. at \$ _____
 Union in. at \$ _____
 Meter in. at \$ _____
 Lead Joints at \$ _____
 Compound Joints at \$ _____
 Maintenance Foreman \$ _____
 Hrs. Water Maint. Man—1 at \$ _____
 Hrs. Water Maint. Man—2 at \$ _____
 Hrs. Garage Foreman at \$ _____
 Hrs. Labor— at \$ _____
 Hrs. Compressor at \$ _____
 Compensation Ins. at \$ _____ per C \$ _____
 Trucking \$ _____
 Pay't Patch \$ _____
Trap By Beecher & Co \$ _____
July 25-1975 \$ _____
 O'head \$ _____

LABOR AND MATERIALS

✓ 4 Copper Lead } Connection Top ----- \$

✓ 1 Curb { Cock- } 4" in Valve \$ 15.00
 { Valve- }
 { ~~52~~ V. }

Service Box { Short 3 1/2 x 4 1/2 } ----- \$
 Old returned { Long 4 1/2 x 5 1/2 }
 { Buff. or Rdway }

✓ 44 Ft. 2 in. { Copper } Pipe # 4" \$ 25.18
 { Galv Iron } ^{0.57¢}
 { Cast Iron }

----- Nipples ----- in. at ----- \$

----- Bushings ----- to ----- in. at ----- \$

Red'g } Couplings ----- to ----- in. at ----- \$
 Inc'g }

✓ 1 Union 4 in. at Sleeve \$ 3.60

----- Meter ----- in. at ----- \$

----- Lead Joints at ----- \$

----- Leadite Joints at ----- \$

----- Hrs. Foreman at ----- \$

17 Hrs. Chauffeur at 6 2/3 \$ 10.63

24 Hrs. Tapper at 7 \$ 15.00

69 Hrs. Labor at 45 \$ 31.05

----- Hrs. Labor at 0 Hrs. Supers \$ 10.00

3 Hrs. Compressor at 8 1/2 \$ 2.63

----- Compensation Ins. ----- \$ 1.72

8 Trucking 75 \$ 6.00

----- Builders Use of Water Patches \$ 18.00

✓ 1 - Bangle 4" 11.7" long \$

✓ 1 - rod 4" 12" " \$

✓ 1 Piece 4" 3 ft with ball \$

✓ 1 " " 4" 12" 7" ball \$

✓ 9 4" joint 20 lbs Hydr \$ 2.00

✓ 9 - Jul 2 " " \$ 45

✓ 2 Gal Gas oil \$ 24

✓ 1 Gal Kerosene \$ 10


141.15

159 - 1938

St. 211-217
 Pl. Warren
 Ave. No. 131-137

Name of Owner
Glens Falls Trust Co

Labor and Mat'l. Report Oct 5/28 1932

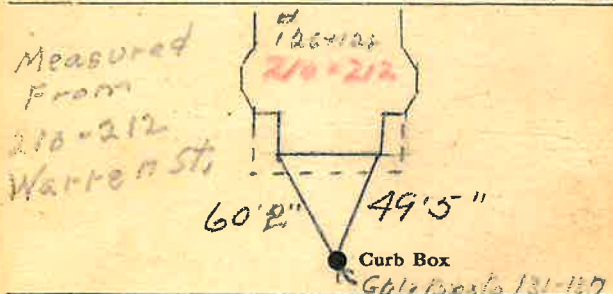

10 Main
 Elev. of Main at tap 5'

Gate at ● Gate at ●
 4" TAP 44' to MAIN

12-10-99 ● Curb Box
 This Line shut off AT GATE
 Not in use -