

LABOR AND MATERIALS

? Copper } Connection ? \$
 Lead }
 1 Curb } Cock } in. \$
 } Valve }
 } T. S. & V. }
 1 Service box { Short 3 1/2 x 4 1/2 }
 Old returned { Long 4 1/2 x 5 1/2 } \$
 } Buff or Rdway }
 ? Ft. in. { Copper } Pipe at \$
 } G. I. ? }
 } C. I. }
 Nipples in. at \$
 Bushings to in. at \$
 Red'g }
 Inc'g } Coupl'gs to in. at \$
 Union in. at \$
 Meter in. at \$
 Lead Joints at \$
 Compound Joints at \$
 Maintenance Foreman \$
 Hrs. Water Maint. Man-1 at \$
 Hrs. Water Maint. Man-2 at \$
 Hrs. Garage Foreman at \$
 Hrs. Labor at \$
 Hrs. Compressor at \$
 Compensation Ins. at \$ per C \$
 Trucking \$
 Pav't Patch \$
 Measured in by \$
 Farmer & Miller \$
 6-10-57 \$
 O'head \$
 \$


St. 219-
 Pl.
 Ave. No 221

Name of Owner

Was Floyd's Lunch.
 Measured in 6/10/57

Labor and Mat'l. Report

? 19

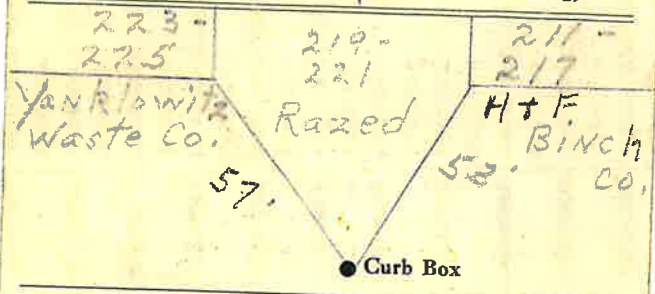

10" Main

Elev. of Main at tap 5

Gate at 10/22 - Not on map

Gate at

● Curb Box

Building Razed.
 Shut off at curb.