


Warren St. Pl. Ave. No. 223

Name of Owner was  
Yanklowitz Waste  
Measured in Bldg.

Labor and Mat'l. Report Aug. 29 1957

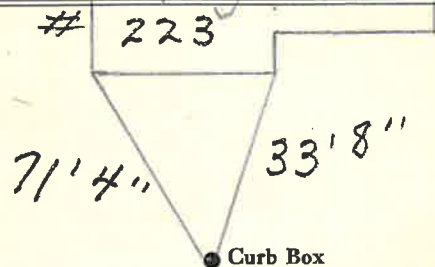

10" Main Elev. of Main at tap ?

Gate at ● Gate at ●  
10/22 - not on map


● Curb Box

H. Binch.

2-8" Taps  
Warren St. Pl. Ave. No. 223

Name of Owner  
Binch & Co.

Labor and Mat'l. Report July 19 64

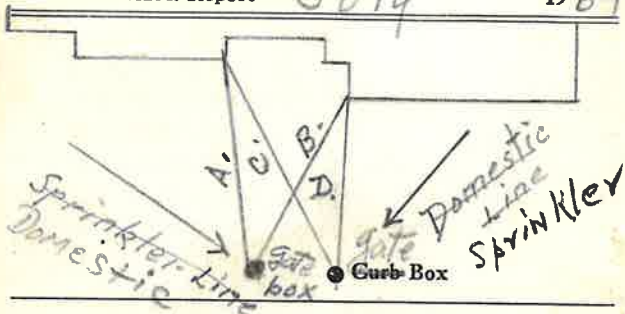

10" Main Elev. of Main at tap 5'

Gate at ● Gate at ●

See Attached Note

A - 66" ● Curb Box  
B - 53' 6" Sprinkler gate 8"  
C - 66' 7"  
D - 53' 5" Domestic, 8" gate

### LABOR AND MATERIALS

?	Copper	Connection	\$	_____	_____
	Lead				
?	Curb	Cock Valve T. S. & V. } _____ in.	\$	_____	_____
1	Service box Old returned	{ Short 3½ x 4½ Long 4½ x 5½ Buff or Rdway }	\$	_____	_____
	Ft. _____ in.	{ Copper G. I. ? C. I. }	} Pipe at	\$	_____
	Nipples	in. at	\$	_____	_____
	Bushings	to _____ in. at	\$	_____	_____
	Red'g Inc'g }	Coup'l'gs to _____ in. at	\$	_____	_____
	Union	in. at	\$	_____	_____
	Meter	in. at	\$	_____	_____
	Lead Joints at		\$	_____	_____
	Compound Joints at		\$	_____	_____
	Maintenance Foreman		\$	_____	_____
	Hrs. Water Maint. Man—1 at		\$	_____	_____
	Hrs. Water Maint. Man—2 at		\$	_____	_____
	Hrs. Garage Foreman	at	\$	_____	_____
	Hrs. Labor—	at	\$	_____	_____
	Hrs. Compressor at		\$	_____	_____
	Compensation Ins. at \$ _____	per C	\$	_____	_____
	Trucking		\$	_____	_____
	Pav't Patch		\$	_____	_____
	<i>Measured in by Ernest Miller 8-29-57</i>		\$	_____	_____
	O'head		\$	_____	_____
			\$	_____	_____

### LABOR AND MATERIALS

*Poured 10" x 8" Tapping Sleeve*

2	Copper	Connection	\$	_____	_____
	Lead				
2	Curb	Cock Valve T. S. & V. } _____ in.	\$	_____	_____
					<i>8" Valve.</i>
2	Service box Old returned	{ Short 3½ x 4½ Long 4½ x 5½ Buff or Rdway }	\$	_____	_____
	Ft. <i>8</i> in.	{ Copper G. I. C. I. }	} Pipe at	\$	_____
	Nipples	in. at	\$	_____	_____
	Bushings	to _____ in. at	\$	_____	_____
	Red'g Inc'g }	Coup'l'gs to _____ in. at	\$	_____	_____
	Union	in. at	\$	_____	_____
	Meter	in. at	\$	_____	_____
	Lead Joints at		\$	_____	_____
	Compound Joints at		\$	_____	_____
	Maintenance Foreman		\$	_____	_____
	Hrs. Water Maint. Man—1 at		\$	_____	_____
	Hrs. Water Maint. Man—2 at		\$	_____	_____
	Hrs. Garage Foreman	at	\$	_____	_____
	Hrs. Labor—	at	\$	_____	_____
	Hrs. Compressor at		\$	_____	_____
	Compensation Ins. at \$ _____	per C	\$	_____	_____
	Trucking		\$	_____	_____
	Pav't Patch		\$	_____	_____
			\$	_____	_____
			\$	_____	_____
	O'head		\$	_____	_____
			\$	_____	_____