

LABOR AND MATERIALS


Copper } Connection _____ \$ _____
 Lead }
 Curb } Cock } _____ in. \$ _____
 } Valve }
 } T. S. & V. }
 Service box } Short 3 1/2 x 4 1/2 }
 Old returned } Long 4 1/2 x 5 1/2 } _____ \$ _____
 40 Ft. 3/4 in. } ~~C.I.~~ } Pipe at _____ \$ _____
 } ~~C.I.~~ }
 Nipples _____ in. at _____ \$ _____
 Bushings _____ to _____ in. at _____ \$ _____
 Red'g }
 Inc'g } Coupl'gs _____ to _____ in. at _____ \$ _____
 Union _____ in. at _____ \$ _____
 Meter _____ in. at _____ \$ _____
 _____ \$ _____
 Compound Joints at _____ \$ _____
 Maintenance Foreman _____ \$ _____
 Hrs. Water Maint. Man-1 at _____ \$ _____
 Hrs. Water Maint. Man-2 at _____ \$ _____
 Hrs. Garage Foreman _____ at _____ \$ _____
 Hrs. Labor _____ at _____ \$ _____
 Hrs. Compressor at _____ \$ _____
 _____ \$ _____
 Trucking _____ \$ _____
 Pav't Patch _____ \$ _____
 _____ \$ _____
 _____ \$ _____
 _____ \$ _____
 _____ \$ _____

WARREN

St. _____
 Pt. _____
 Ave. No. 235-37

Name of Owner
 BARBER - INSUR. AGEN.

Labor and Mat'l. Report 1925

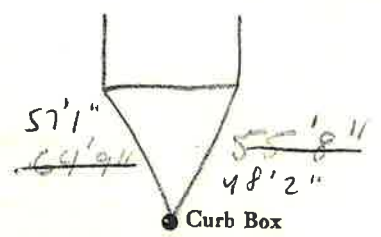

Main _____ Elev. of Main at tap _____

Gate at • _____ Gate at _____
 3/4" COPPER 40' to MAIN

• Curb Box

TAX ID# 303.18-20-3