


32-B  
Labor and Material Report May 4 1932

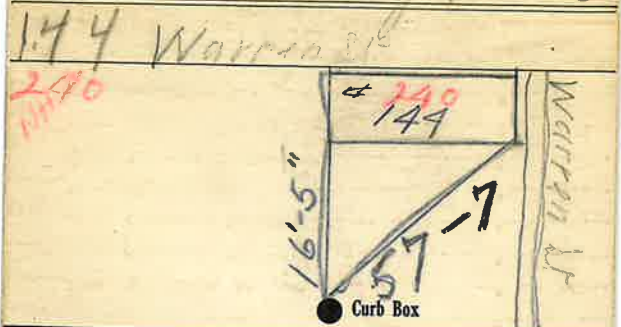

Geer St  
4 Main Elev. of Main at tap 42


Gate at ● 9' to MAIN Gate at ●

● Curb Box

New Tap  
Tap on Geer St  
TAX ID# 303.18-18-4

OK 9/10

32-B  
Labor and Material Report May 4 1932

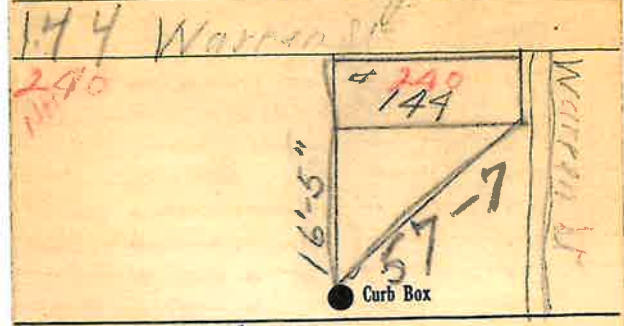

Geer St  
4 Main Elev. of Main at tap 42

Gate at ● 9' to MAIN Gate at ●

● Curb Box

New Tap  
Tap on Geer St  
TAX ID# 303.18-18-4

OK 9/10