


LABOR AND MATERIALS

- 3/4" Copper } Connection _____ \$
- _____ Curb } ~~Lead~~ } Valve } T.S. & V. } _____ in. _____ \$
- _____ Service box { Short 3-1/2 x 4-1/2 } _____ \$
- _____ Old returned { Long 4-1/2 x 5-1/2 } _____ \$
- 11 Ft. _____ in. { Copper } Pipe at _____ \$
- _____ Nipples _____ in. at _____ \$
- _____ Bushings _____ to _____ in. at _____ \$
- _____ Red'g _____
- _____ Inc'g _____
- _____ Union _____ in. at _____ \$
- _____ Meter _____ in. at _____ \$
- _____ Compound Joints at _____ \$
- _____ Maintenance Foreman _____ \$
- _____ Hrs. Water Maint. Man - 1 at _____ \$
- _____ Hrs. Water Maint. Man - 2 at _____ \$
- _____ Hrs. Garage Foreman _____ at _____ \$
- _____ Hrs. Labor _____ at _____ \$
- _____ Hrs. Compressor at _____ \$
- _____ Trucking _____ \$
- _____ Pav't Patch _____ \$
- _____ \$
- _____ \$
Wash burn ^{SE} Ave. No. 7

Name of Owner CLUTE BUILDERS

Labor and Mat'l. Report 8/2011

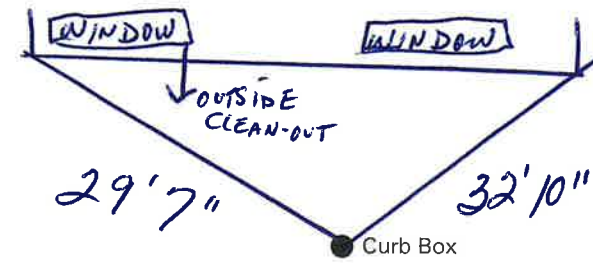

6" Main Elev. of Main at tap 7 1/2

Gate at ● Gate at ●
TAX ID # 302.16-19-2.4

● Curb Box

11' 3/4 copper to main
OUTSIDE CLEAN-OUT