


LABOR AND MATERIALS

$3/4'$ Copper } Connection _____ \$ _____
~~Lead~~ }
 Curb } Valve } _____ in. _____ \$ _____
 T.C. & V. }
 Service box { Short 3-1/2 x 4-1/2 } _____ \$ _____
 Old returned { Long 4-1/2 x 5-1/2 }
 11 Ft. _____ in. { Copper } Pipe at _____ \$ _____
 { G.I. }
 { C.I. }
 Nipples _____ in. at _____ \$ _____
 Bushings _____ to _____ in. at _____ \$ _____
 Red'g _____
 Inc'g _____
 Union _____ in. at _____ \$ _____
 Meter _____ in. at _____ \$ _____
 _____ \$ _____
 Compound Joints at _____ \$ _____
 Maintenance Foreman _____ \$ _____
 Hrs. Water Maint. Man - 1 at _____ \$ _____
 Hrs. Water Maint. Man - 2 at _____ \$ _____
 Hrs. Garage Foreman _____ at _____ \$ _____
 Hrs. Labor _____ at _____ \$ _____
 Hrs. Compressor at _____ \$ _____
 _____ \$ _____
 Trucking _____ \$ _____
 Pav't Patch _____ \$ _____
 _____ \$ _____
 _____ \$ _____
Washburn ST Ave. No. 9
~~4#~~

Name of Owner CLUTE BUILDERS

Labor and Mat'l. Report # 8/2011

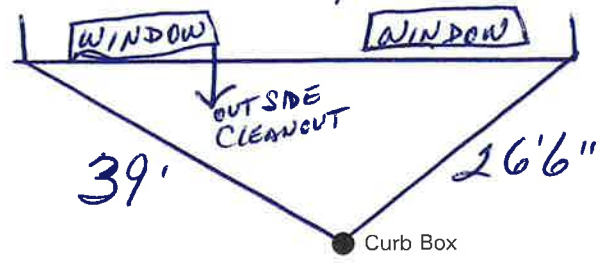

$6''$ Main Elev. of Main at tap $7\frac{1}{2}'$

Gate at ● Gate at ●

TAX ID # 302.16-19-2.5

● Curb Box

$11' 3/4$ Copper to main

OUTSIDE CLEAN-OUT