

**Labor and Materials**


1	Copper	Connection	3/4"	\$ 2.60		
	Lead					
1	Curb	Cock Valve	3/4" in.	\$ 2.27		
		T.S. & V.				
1	Service Box	Short	3 1/2 x 4 1/2	\$ 1.59		
	Old returned	Long	4 1/2 x 5 1/2			
		Build. or Rwy				
13	Ft.	Copper	3/4" in.			
		Galv. Iron	Pipe at			
		Cast Iron				
	Nipples		in. at	\$		
	Bushings		to in. at	\$		
	Red'g	Couplings	to in. at	\$		
	Inc'g					
	Union		in. at	\$		
	Meter		in. at	\$		
	Lbs. Br. Stone		at	\$		
	Lbs. Sand		at	\$		
	Bags Cement		at	\$		
	Paving Brick	Mack Red Asphalt	at	\$		
	Lead Joints					\$
	Leadite Joints					\$
2	Hrs. Foreman		at	\$ 1.25		
7	Hrs. Common Labor		at	\$ 3.15		
	Hrs. Common Labor		at	\$		
	Hrs. Mason		at	\$		
	Hrs. Mason's Helper		at	\$		
	Hrs. Compressor		at	\$		
	Compensation Ins			\$ .14		
	Trucking			\$ 1.00		
	Builders' Use of Water			\$		

Total \$ 12.00

31-76-12

Labor and Material Report July 27 1931

126 Washburn Ave sketch

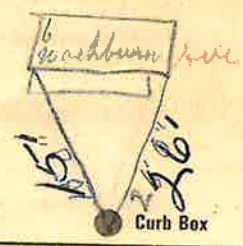

6" Main Elev of Main at tap 4"

Gate at ● Gate at ●

3/4" Copper 13' to main

● Curb Box

New House  
Lattimore says this should  
be marked 6" not 4"

TAX ID # 302.20-6-6