


LABOR AND MATERIALS

1	Copper Lead	Connection	3/4"	\$
1	Curb	Cock Valve T.S. & V.	3/4" in.	\$
1	Service box Old returned	Short 3 1/2 x 4 1/2 Long 4 1/2 x 5 1/2 Buff or Rdway		\$
20	Ft. 3/4 in.	Copper C.I. C.I.	Pipe at	\$
	Nipples	in. at		\$
	Bushings	to in. at		\$
	Red'g Inc'g	Coupl'gs to in. at		\$
	Union	in. at		\$
	Meter	in. at		\$
	Lead Joints	at		\$
	Compound Joints	at		\$
	Maintenance Foreman			\$
	Hrs. Water Maint. Man	1 at		\$
	Hrs. Water Maint. Man	2 at		\$
	Hrs. Garage Foreman	at		\$
	Hrs. Labor	at		\$
	Hrs. Compressor	at		\$
	Compensation Ins.	at \$ per C		\$
	Trucking			\$
	Pav't Patch			\$
	Tap Dug up + Found to be Copper.			\$
		8-2-69.		\$
	O'head			\$
				\$

Washburn ~~St.~~ Ave. No. 16

Name of Owner
TAX ID # 302.20-6-8

Labor and Mat'l. Report Aug. 2 1969

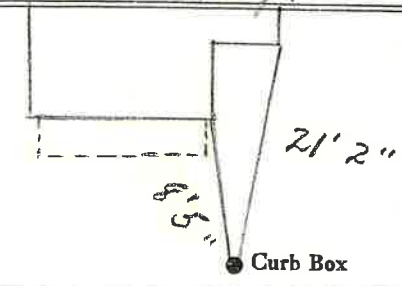

6" Main Elev. of Main at tap 6'

Gate at • Gate at
3/4" Copper 20' to main

• Curb Box

Copy,