


Labor and Materials

1	Copper Lead	Connection	3/4"	\$ 2.60
1	Curb	Cock Valve T-S & V.	3/4" in.	\$ 2.27
1	Service Box	Short 3/4"x1/2"		\$ 1.38
	Old returned	Long 4"x3/4"		
		Buff or Rdway		
27 23	Ft.	3/4" in.	Copper Galv. Iron Cast-iron Pipe at	\$ 4.14
	Nipples	in. at		\$
	Bushings	to in. at		\$
	Red'g Inc'g	Couplings to in. at		\$
	Union	in. at		\$
	Meter	in. at		\$
	Lbs. Br. Stone	at		\$
	Lbs. Sand	at		\$
	Bags Cement	at		\$
	Paving Brick	Mack Red Asphalt at		\$
	Lead Joints	at		\$
	Leadite Joints	at		\$
5	Hrs. Foreman	at		\$ 3.13
1.4	Hrs. Common Labor	at		\$ 6.20
	Hrs. Common Labor	at		\$
	Hrs. Mason	at		\$
	Hrs. Mason's Helper	at		\$
	Hrs. Compressor	at		\$
	Compensation Ins.			\$ 29
	Trucking			\$ 1-
	Builders' Use of Water	Patch		\$ 5-
Total \$				26.11

31-141 **E23** Labor and Material Report Oct 5 1971

3/4" tap at 35 Washington at

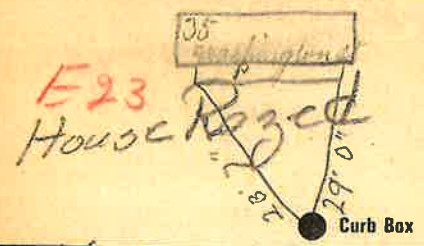

E23
House Razed
Now Used for hose connection
First National Bank Building
6" Main Elev of Main at tap 4 1/2

Gate at 3/4" copper 27' 40" MAIN Gate at

● Curb Box
Old tap shut off
TAX ID# 302.20-24-5