


Labor and Materials

Copper } Connection		\$ 320
Lead } Connection		
Curb { Cock	} 3/4 in.	\$ 1.80
Valve		
T.S. & V.		
Service Box { Sheet Metal	} Long 4 1/2 x 5 1/2	\$ 1.40
Old returned		
19 1/2 Ft. in. Copper	} Pipe at 3/4	\$ 286
Galv. Iron		
Cast Iron		
Nipples	in. at	\$
Bushings	to in. at	\$
Red'g } Couplings	to in. at	\$
Inc'g }		
Union	in. at	\$
Meter	in. at	\$
Lbs. Br. Stone	at	\$
Lbs. Sand	at	\$
Bags Cement	at	\$
Paving Brick { Mack	} at	\$
Red Asphalt		
Lead Joints	at	\$
Leadite Joints	at	\$
4 Hrs. Foreman	at 6.25	\$ 2.50
Hrs. Common Labor	at	\$
8 Hrs. Common Labor	at 40%	\$ 3.25
Hrs. Mason	at	\$
Hrs. Mason's Helper	at	\$
Hrs. Compressor	at	\$
Compensation Ins.		\$ 1.15
Trucking		\$ 1.00
Builders' Use of Water		\$
Total		\$ 536

27-25
 Labor and Material Report
 22 1925

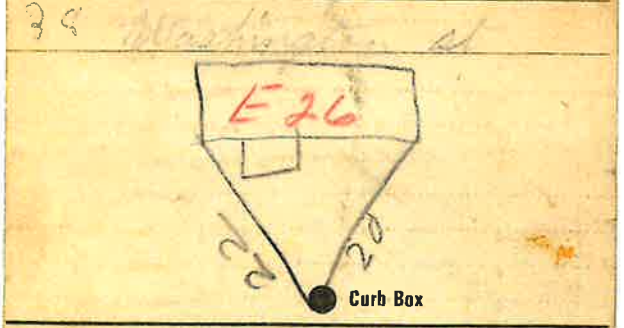

Shut off at Curb 7-16-1973
 Main Elev. of Main at tap 4 1/2

Gate at IN Sidewalk Gate at

3/4" copper
 Curb Box
 70'-9"
 Curb Box for 28 E. Washington

19' to main
 Curb Box
 For 26 E. Washington