

### Labor and Materials


1	Copper	Lead	Connection	31	\$	320
1	Curb	Cock Valve	T. S. & V.	2 1/2 in.	\$	1.00
19	Service Box	Short 3 1/2 x 4 1/2	Old returned	Long 4 1/2 x 5 1/2	\$	130
7	Ft.	3/4 in.	Copper Galv. Iron	Cast Iron	Pipe at	\$ 198
	Nipples		m. at		\$	
	Bushings		to in. at		\$	
	Red'g Inc'g	Couplings		to in. at	\$	
	Union		in. at		\$	
	Meter		in. at		\$	
	Lbs. Br. Stone		at		\$	
	Lbs. Sand		at		\$	
	Bags Cement		at		\$	
	Paving Brick	Mack Red Asphalt		at	\$	
	Lead Joints		at		\$	
	Leadite Joints		at		\$	
3	Hrs. Foreman		at	0.25	\$	187
2	Hrs. Common Labor		at	50	\$	100
13	Hrs. Common Labor		at	400	\$	520
	Hrs. Mason		at		\$	
	Hrs. Mason's Helper		at		\$	
	Hrs. Compressor		at		\$	
	Compensation Ins.				\$	22
1	Trucking				\$	100
	Builders' Use of Water				\$	
					Total	\$ 1685

### Labor and Material Report

23

1927

East Washington ST.

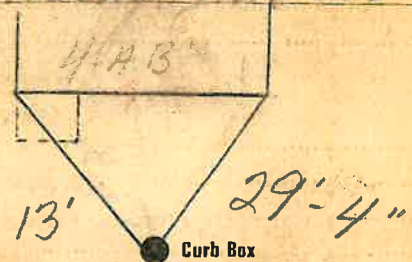

Main

Elev. of Main at top

Gate at

3/4" Copper

Gate at

19' to MAIN

Curb Box

Unknown address - 10/22