

## Labor and Materials

1	Copper <del>Lead</del>	Connection	3/4				\$ 1.16
1	Curb	Cock Valve T-S-&V	3/4	in			\$ 1.93
1	Service Box	Short 3 1/2 x 4 1/2 Long 4 1/2 x 5 1/2 Buff. or Rdway					\$ 1.77
19	Old returned						
10	Ft. 3/4 in.	Copper Galv Iron Cast Iron		Pipe at			\$ 7.70
	Nipples			in. at			\$
	Bushings			to in. at			\$
	Red'g	Coplings		to in. at			\$
	Union			in. at			\$
	Meter			in. at			\$
	Lead Joints			at			\$
	Leadite Joints			at			\$
	Hrs. Foreman			at			\$
2 1/2	Hrs. Chauffeur			at			\$ 1.57
1	Hrs. Tapper			at			\$ 6.70
1 1/2	Hrs. Labor			at			\$ 7.92
	Hrs. Labor			at			\$
	Hrs. Compressor			at			\$
	Compensation Ins.			at			\$ 16
	Trucking			at			\$ 1
	Builders Use of Water			at			\$
				at			\$
				at			\$
				at		Top Key Hand	\$ 13.64


146-1937

St. **E 10**  
Pl. \_\_\_\_\_  
Ave. No. **24**

Name of Owner \_\_\_\_\_

*Dolly*

Labor and Mat'l. Report *Comptrol* 1937

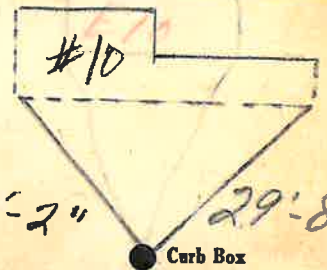

TAX ID# 302.20-18-21

*1/4* Main Elev. of Main at tap *5*

Gate at Gate at  
*3/4\"* Copper *19'* to MAIN

● Curb Box

*Old lead disc*

*A*