


East  
Washington St. Pl. Ave. No. 13

Name of Owner  
1<sup>st</sup> Nat. Bank

Labor and Mat'l. Report July 27, 1978

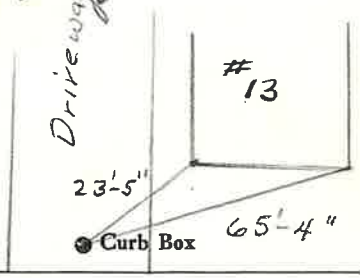

6" Main Elev. of Main at tap 5'

Gate at • Gate at  
1 1/2" copper 30' to main

• Curb Box

Inside Edge of Walk  
TAX ID # 302.20-24-10  
*MS*


LSM-5C-6-1-67

147-1937

Washington St. Pl. Ave. No. 25


Name of Owner  
Mrs V G Wood

Labor and Mat'l. Report Sept 9 1937

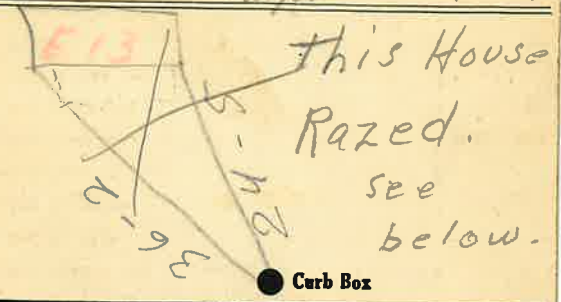

used same tap,  
6" Main Elev. of Main at tap 4 1/2'

Gate at • Gate at

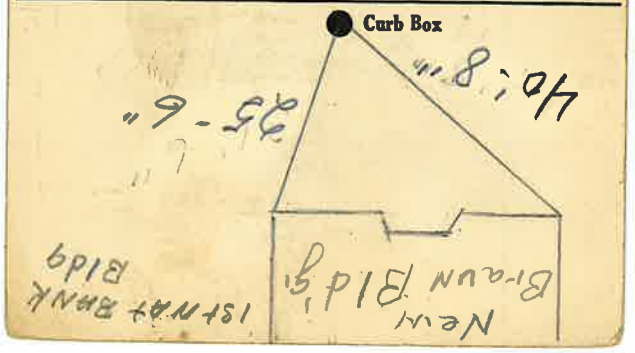



142-1931

St. Washington  
Ave. No. 25

Name of Owner

Mrs V G Wood

Labor and Mat'l. Report Rept 9 1937


This House

Razed.

see

below.

● Carb Box

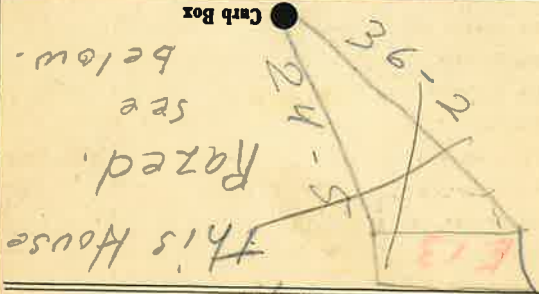

used same tap.

Main

Elev. of

4 1/2

Main at tap

● Gate at

● Gate at

