


Labor and Material Report

E 15
Nov 22 1915

27 Washington St
NEW HOUSE

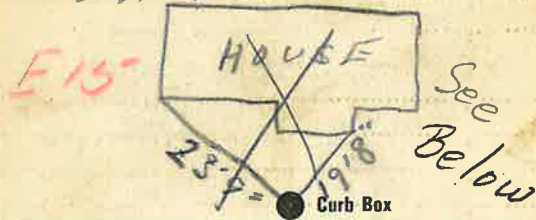

TAX ID # 302.20-24-9

6" Main

Elev. of Main at tap 5

Gate at ●

● Gate at

● Curb Box

See Attached Note

by
#13 #

MEASUREMENTS FOR
15 E. WASHINGTON

1st National Bank
Bldg #13

43'

47'-3"

Curb Box for #15 E.
Washington St
IN Sidewalk

Hydrant
Across the
Street

Labor and Materials

7	Copper	}	Connection.....		\$
	Head				
1	Curb	{	Cock		
			Valve	in	\$
			T. S. & V.		
1	Service Box	{	Short 3 1/2 x 4 1/2		
	Old returned		Long 3 1/2 x 5 1/2		\$
			Buff. or Rdway		
20	Ft.	3/4	in.	{	
				Copper	
				Cast Iron	
				} Pipe at.....	\$
	Nipples		in. at.....		\$
	Bushings		to..... in. at.....		\$
	Red'g	{	Couplings..... to..... in. at.....		\$
	Inc'g				
	Union		in. at.....		\$
	Meter		in. at.....		\$
	Lbs. Br. Stone		at.....		\$
	Lbs. Sand		at.....		\$
	Bags Cement		at.....		\$
	Paving Brick	{	Mack		
			Red	at.....	\$
			Asphalt		
	Lead Joints		at.....		\$
	Leadite Joints		at.....		\$
	Hrs. Foreman		at.....		\$
	Hrs. Common Labor		at.....		\$
10	Hrs. Common Labor		at.....		\$
	Hrs. Mason		at.....		\$
	Hrs. Mason's Helper		at.....		\$
	Hrs. Compressor		at.....		\$
	Compensation Ins.			\$
1	Trucking			\$
1	Builders' Use of Water			\$
Total \$.....					