


LABOR AND MATERIALS

1	Copper	} Connection <sup>3/4"</sup>	\$
1	Lead		
1	Curb	} <sup>3/4"</sup> in.	\$
	Valve		
	T.S. & V.		
1	Service box	} Short 3 1/2 x 4 1/2	\$
	Old returned		Long 4 1/2 x 5 1/2
			Buff or Rdway
22	3/4 in.	} Pipe at	\$
			Copper
		C.I.	
		C.I.	
	Nipples	in. at	\$
	Bushings	to in. at	\$
1	Red'g	} <sup>3/4" Cop</sup> Coupl'gs <sup>Cop</sup>	\$
1	Inc'g		in. at
	Union	in. at	\$
	Meter	in. at	\$
	Lead Joints	at	\$
	Compound Joints	at	\$
	Maintenance Foreman		\$
	Hrs. Water Maint. Man—1	at	\$
	Hrs. Water Maint. Man—2	at	\$
	Hrs. Garage Foreman	at	\$
	Hrs. Labor—	at	\$
	Hrs. Compressor	at	\$
	Compensation Ins. at \$	per C	\$
	Trucking		\$
	Pav't Patch		\$
	Tap by Gifford		\$
	T & CO. 9-18-59		\$
	O'head		\$
			\$

St. West Washington Pl. Ave. No. 11

Name of Owner \_\_\_\_\_

Labor and Mat'l. Report Sept. 18 1959

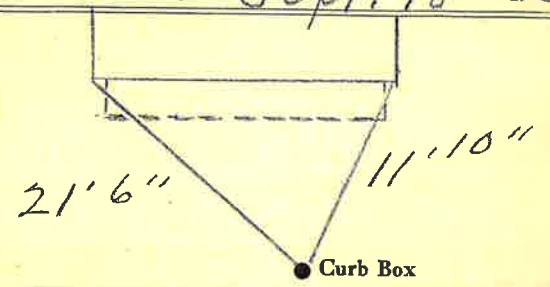

4" Main Elev. of Main at tap 5 1/2'

Gate at • Gate at •  
3/4" Copper 22' to main

• Curb Box  
 House Razed 1970  
 not on map