

LABOR AND MATERIALS


_____	Copper	} Connection	_____	\$ _____
_____	Lead			
_____	Curb	} Cock Valve T.S. & V.	_____ in.	\$ _____
_____	Service box		{ Short 3-1/2 x 4-1/2 Old returned Long 4-1/2 x 5-1/2 }	_____
_____	Ft. _____ in.	{ Copper G.I. C.I. }		Pipe at _____
_____	Nipples _____		in. at _____	\$ _____
_____	Bushings _____	to _____ in. at _____	\$ _____	
_____	Red'g			\$ _____
_____	Inc'g			\$ _____
_____	Union _____	in. at _____	\$ _____	
_____	Meter _____	in. at _____	\$ _____	
_____				\$ _____
_____	Compound Joints at _____		\$ _____	
_____	Maintenance Foreman _____		\$ _____	
_____	Hrs. Water Maint. Man - 1 at _____		\$ _____	
_____	Hrs. Water Maint. Man - 2 at _____		\$ _____	
_____	Hrs. Garage Foreman _____	at _____	\$ _____	
_____	Hrs. Labor _____	at _____	\$ _____	
_____	Hrs. Compressor at _____		\$ _____	
_____			\$ _____	
_____	Trucking _____		\$ _____	
_____	Pav't Patch _____		\$ _____	
_____			\$ _____	
_____			\$ _____	
_____			\$ _____	
_____			\$ _____	

21 Water

St
Pl. Ave. No. 21

Name of Owner
TAX ID # 309.16-3-6.2

Labor and Mat'l. Report 19 2014

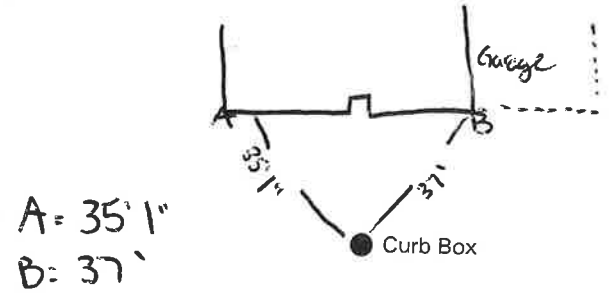

_____ Main Elev. of Main at tap _____

Gate at ● ● Gate at

● Curb Box