

LABOR AND MATERIALS

3/4	Copper	Connection	_____	\$ _____
	Lead			
	Curb	Cock Valve T.S. & V. } _____ in.	_____	\$ _____
	Service box	Short 3 1/2 x 4 1/2 } _____	_____	\$ _____
	Old returned			
	Ft. 3/4 in.	{ Copper } _____	Pipe at _____	\$ _____
		{ C.I. }		
		{ C.I. }		
	Nipples	in. at _____		\$ _____
	Bushings	to _____ in. at _____		\$ _____
	Red'g } _____	Coupl'gs to _____ in. at _____		\$ _____
	Inc'g }			
	Union	in. at _____		\$ _____
	Meter	in. at _____		\$ _____
	Compound Joints	at _____		\$ _____
	Maintenance Foreman	_____		\$ _____
	Hrs. Water Maint. Man-1	at _____		\$ _____
	Hrs. Water Maint. Man-2	at _____		\$ _____
	Hrs. Garage Foreman	at _____		\$ _____
	Hrs. Labor	at _____		\$ _____
	Hrs. Compressor	at _____		\$ _____
	Trucking	_____		\$ _____
	Pav't Patch	_____		\$ _____
				\$ _____
				\$ _____
				\$ _____
				\$ _____


Lot #5 P

Water Street St. Pl. Ave. No. 25

Name of Owner
Louis La Roche

TAX ID # 309.16-3-6.1

Labor and Mat'l. Report 7/13 1997

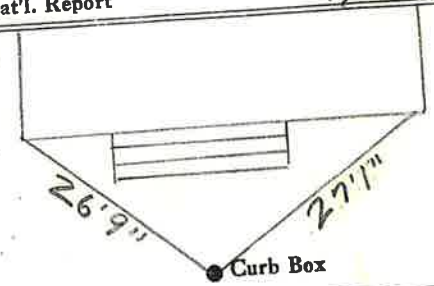

	Elev. of Main at tap _____
Main	
Gate at ●	● Gate at
	● Curb Box