

LABOR AND MATERIALS

Copper	Lead	Connection		\$	
Curb	Cock Valve T.S. & V.	}	in.	\$	
Service box	}	Short 3½ x 4½			
Old returned		Long 4½ x 5½		\$	
8 Ft.	¾ in.	Copper G.I. G.I.	} Pipe at	\$	
Nipples	in.	at		\$	
Bushings	to	in.	at	\$	
Red'g Inc'g	} Coupl'gs	to	in.	at	\$
Union	in.	at		\$	
Meter	in.	at		\$	
Compound Joints	at			\$	
Maintenance Foreman				\$	
Hrs. Water Maint. Man	1	at		\$	
Hrs. Water Maint. Man	2	at		\$	
Hrs. Garage Foreman		at		\$	
Hrs. Labor		at		\$	
Hrs. Compressor	at			\$	
Trucking				\$	
Pav't Patch				\$	
				\$	
				\$	
				\$	
				\$	


WATER

St.
Pl. No. 27

Name of Owner _____

Labor and Mat'l. Report _____

1978

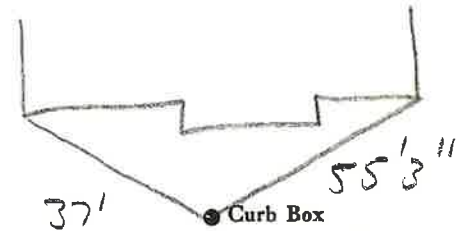

Main

Elev. of
Main at tap

Gate at ●

● Gate at

¾" copper

8' to main

● Curb Box