

LABOR AND MATERIALS

Copper	} Connection		\$	
Lead				
Curb	} Cock	} in.	\$	
				} Valve
Service box	} Short 3½ x 4½	}	\$	
Old returned				} Long 4½ x 5½
19 Ft.	3/4 in.	{ Copper G.I. C.I. } Pipe at	\$	
Nipples	in. at		\$	
Bushings	to in. at		\$	
Red'g	} Coupl'gs	to in. at	\$	
Inc'g				
Union	in. at		\$	
Meter	in. at		\$	
Compound Joints	at		\$	
Maintenance Foreman			\$	
Hrs. Water Maint. Man-1	at		\$	
Hrs. Water Maint. Man-2	at		\$	
Hrs. Garage Foreman	at		\$	
Hrs. Labor-	at		\$	
Hrs. Compressor	at		\$	
Trucking			\$	
Pav't Patch			\$	
			\$	
			\$	
WATER


St. Pt. Ave. No. 49

Name of Owner

TAX ID # 309.16-4-3

Labor and Mat'l. Report

1992

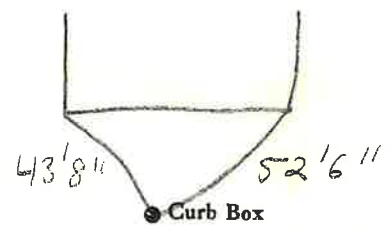

Main

Elev. of Main at tap 7

Gate at ●

● Gate at

● Curb Box