

LABOR AND MATERIALS

Copper } Connection	_____	\$ _____
Lead } _____	_____	\$ _____
Curb } Cock	} _____ in. _____	\$ _____
} Valve		
} T. S. & V.		
Service box } Short 3½ x 4½	} _____	\$ _____
Old returned } Long 4½ x 5½		
21 Ft. ¾ in. } Copper	} Pipe at _____	\$ _____
} C.I.		
} C.I.		
Nipples _____ in. at _____		\$ _____
Bushings _____ to _____ in. at _____		\$ _____
Red'g } Inc'g } Coupl'gs _____ to _____ in. at _____		\$ _____
Union _____ in. at _____		\$ _____
Meter _____ in. at _____		\$ _____
_____		\$ _____
Compound Joints at _____		\$ _____
Maintenance Foreman _____		\$ _____
Hrs. Water Maint. Man—1 at _____		\$ _____
Hrs. Water Maint. Man—2 at _____		\$ _____
Hrs. Garage Foreman _____ at _____		\$ _____
Hrs. Labor _____ at _____		\$ _____
Hrs. Compressor at _____		\$ _____
_____		\$ _____
Trucking _____		\$ _____
Pav't Patch _____		\$ _____
_____		\$ _____
_____		\$ _____
WATER


St. _____
 Pt. _____
 Ave. No. 51

Name of Owner _____

TAX ID # 309.16-4-2

Labor and Mat'l. Report _____

1993

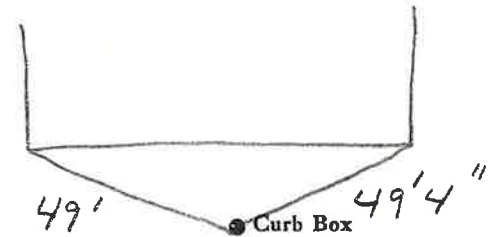

8" Main

Elev. of Main at tap 7'

Gate at ●

● Gate at

● Curb Box