

LABOR AND MATERIALS

Copper	Lead	Connection		\$	
Curb	Cock Valve	T. S. & V.	} in.	\$	
Service box	Old returned	Short 3 1/2 x 4 1/2	}	\$	
		Long 4 1/2 x 5 1/2			
Ft.	3/4 in.	Copper	} Pipe at	\$	
		G.I.			
		C.I.			
Nipples	in.	at		\$	
Bushings	to	in.	at	\$	
Red'g	} Coupl'gs	to	in.	at	\$
Inc'g					
Union	in.	at		\$	
Meter	in.	at		\$	
				\$	
Compound Joints	at			\$	
Maintenance Foreman				\$	
Hrs. Water Maint. Man-1	at			\$	
Hrs. Water Maint. Man-2	at			\$	
Hrs. Garage Foreman	at			\$	
Hrs. Labor	at			\$	
Hrs. Compressor	at			\$	
				\$	
Trucking				\$	
Pav't Patch				\$	
				\$	
				\$	
St. 53
~~Pl.~~
 Ave. No.

WATER

Name of Owner _____

TAX ID # 309.16-4-1

Labor and Mat'l. Report 19 93

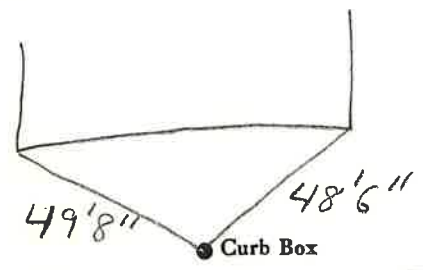

8"

Main Elev. of Main at tap _____

Gate at ● ● Gate at

● Curb Box