


LABOR AND MATERIALS

Copper	} Connection		\$
Lead			
1 Curb	} Gock- Valve T. S. & V.	6 in.	\$
1 Service box		} Short 3 1/2 x 4 1/2 Long 4 1/2 x 5 1/2 Buff or Rdway	
Old returned			\$
Ft. in.	} Copper G. I. C. I.		Pipe at
Nipples		in. at	\$
Bushings	to	in. at	\$
Red'g	} Coupl'gs	to	in. at
Inc'g			
Union		in. at	\$
Meter		in. at	\$
Lead Joints		at	\$
Compound Joints		at	\$
Maintenance Foreman			\$
Hrs. Water Maint. Man-1		at	\$
Hrs. Water Maint. Man-2		at	\$
Hrs. Garage Foreman		at	\$
Hrs. Labor		at	\$
Hrs. Compressor		at	\$
Compensation Ins. at \$		per C	\$
Trucking			\$
Pav't Patch			\$
O'head			\$

Water St. Pl. Ave. No.

Name of Owner City of Kings Falls  
Sawyer Pumping Sta.

Labor and Mat'l. Report Aug. 27 - 19 00

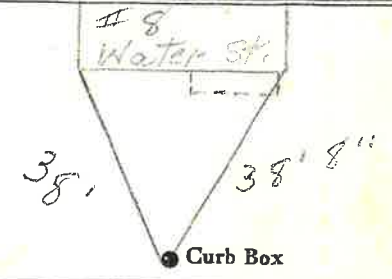

6" Main Elev. of Main at tap 5'

Gate at • Gate at

• Curb Box  
6" gate measured  
from #8 Water St.  
shut off for Sawyer  
Pumping Station