

LABOR AND MATERIALS

Copper	} Connection	_____	\$ _____	
Lead				
Curb	} Cock Valve T. S. & V.	_____ in.	\$ _____	
Service box		} Short 3½ x 4½ Long 4½ x 5½ Buff or Rdway	_____	\$ _____
Old returned				
15 Ft. 3/4 in.	} Copper C.I. C.I.	Pipe at _____	\$ _____	
Nipples		in. at _____	\$ _____	
Bushings	to _____ in. at _____	\$ _____		
Red'g } Inc'g }	Coupl'gs	to _____ in. at _____	\$ _____	
Union	in. at _____	\$ _____		
Meter	in. at _____	\$ _____		
Lead Joints	at _____	\$ _____		
Compound Joints	at _____	\$ _____		
Maintenance Foreman	_____	\$ _____		
Hrs. Water Maint. Man-1	at _____	\$ _____		
Hrs. Water Maint. Man-2	at _____	\$ _____		
Hrs. Garage Foreman	at _____	\$ _____		
Hrs. Labor	at _____	\$ _____		
Hrs. Compressor	at _____	\$ _____		
Compensation Ins.	at \$ _____ per C	\$ _____		
Trucking	_____	\$ _____		
Pav't Patch	_____	\$ _____		
	_____	\$ _____		
	_____	\$ _____		
	_____	\$ _____		
O'head	_____	\$ _____		
	_____	\$ _____		


St. 8
Ave. No. 8

WATER

Name of Owner _____

TAX ID # 309.12-11-66

Labor and Mat'l. Report 19

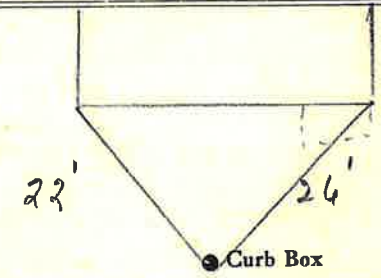

Main Elev. of
Main at tap _____

Gate at • 2' 4" • Gate at _____

HYD 9' LAT.

3/4" COPPER • Curb Box

15' from main