


LABOR AND MATERIALS

_____	Copper } Connection	_____	\$	_____
_____	Lead } Cock			
_____	Curb } Valve	_____ in.	\$	_____
		T.S. & V. }		
_____	Service box { Short 3-1/2 x 4-1/2 }	_____	\$	_____
_____	Old returned { Long 4-1/2 x 5-1/2 }	_____	\$	_____
_____	Ft. _____ in. { Copper } Pipe at	_____	\$	_____
		{ G.I. }		
		{ C.I. }		
_____	Nipples _____ in. at	_____	\$	_____
_____	Bushings _____ to _____ in. at	_____	\$	_____
_____	Red'g			
_____	Inc'g			
_____	Union _____ in. at	_____	\$	_____
_____	Meter _____ in. at	_____	\$	_____
_____			\$	_____
_____	Compound Joints at	_____	\$	_____
_____	Maintenance Foreman	_____	\$	_____
_____	Hrs. Water Maint. Man - 1 at	_____	\$	_____
_____	Hrs. Water Maint. Man - 2 at	_____	\$	_____
_____	Hrs. Garage Foreman _____ at	_____	\$	_____
_____	Hrs. Labor _____ at	_____	\$	_____
_____	Hrs. Compressor at	_____	\$	_____
_____			\$	_____
_____	Trucking	_____	\$	_____
_____	Pav't Patch	_____	\$	_____
_____			\$	_____
_____			\$	_____
9 Water St. Ave. No. 9
 Name of Owner

Labor and Mat'l. Report 19 2014

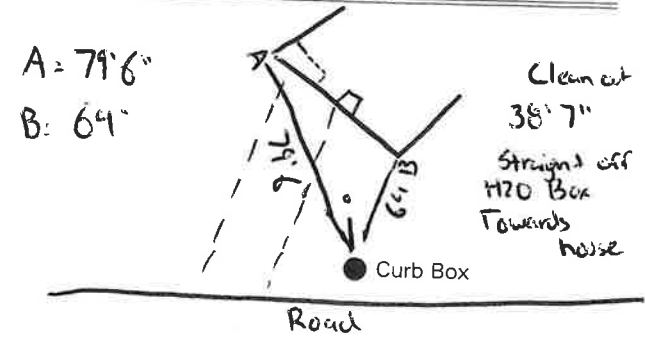

_____ Main Elev. of Main at tap _____
 Gate at ● Gate at ●
 TAX ID # 309.16-3-7.1
 ● Curb Box