



### Labor and Materials


Copper } Connection.....	\$
Lead } .....	\$
1. Curb { Cock Valve } 3/4 in.....	\$
	T.S. & V. }
..... Service Box { Short 3 1/2 x 4 1/2 } .....	\$
..... Old returned { Long 4 1/2 x 5 1/2 } .....	\$
	Buff. or Rdway }
5. Ft. 3/4 in. { Copper Galv. Iron } Pipe at.....	\$
	Cast Iron }
..... Nipples..... in. at.....	\$
..... Bushings..... to..... in. at.....	\$
2. Red 1/2 } Couplings. 3/4 to 1 in. at.....	\$
Inc'x }	
..... Union..... in. at.....	\$
..... Meter..... in. at.....	\$
..... Lbs. Br. Stone at.....	\$
..... Lbs. Sand at.....	\$
..... Bags Cement at.....	\$
..... Paving Brick { Mack Red } at.....	\$
	Asphalt }
..... Lead Joints at.....	\$
..... Leadite Joints at.....	\$
..... Hrs. Foreman at.....	\$
..... Hrs. Common Labor at.....	\$
..... Hrs. Common Labor at.....	\$
..... Hrs. Mason at.....	\$
..... Hrs. Mason's Helper at.....	\$
..... Hrs. Compressor at.....	\$
..... Compensation Ins.....	\$
..... Trucking.....	\$
..... Builders' Use of Water.....	\$
Total \$.....	

Labor and Material Report

Sept 28

1927

Extending service at 1 Webb Ave

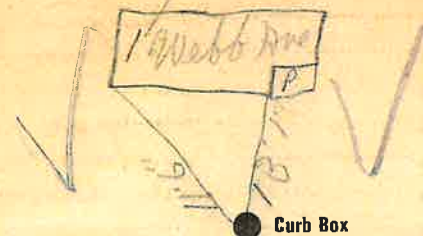

Main

Elev. of Main at tap

Gate at ●

● Gate at

● Curb Box