


LABOR AND MATERIALS

~~1~~ Copper } Connection ^{3/4"} \$ _____
~~Lead~~ }
 1 Curb } Cock } 3/4 in. \$ _____
 } Valve }
 } T. S. & V. }
 1 Service box } Short 3 1/2 x 4 1/2 }
 Old returned } Long 4 1/2 x 5 1/2 } \$ _____
 } Buff. or Rdway }
 37 Ft. ^{3/4} in. } Copper } Pipe at \$ _____
 } ~~Ct.~~ }
 } ~~Ct.~~ }
 Nipples _____ in. at \$ _____
 Bushings _____ to _____ in. at \$ _____
 1 Red'g } Coupl'gs 1 to ^{3/4} in. at \$ _____
 Inc'g }
 1 Union ^{3/4} in. at ^{Male} \$ _____
 Meter _____ in. at ^{Adapter} \$ _____
 Lead Joints at \$ _____
 Compound Joints at \$ _____
 Maintenance Foreman \$ _____
 Hrs. Water Maint. Man—1 at \$ _____
 Hrs. Water Maint. Man—2 at \$ _____
 Hrs. Garage Foreman _____ at \$ _____
 Hrs. Labor— _____ at \$ _____
 Hrs. Compressor at \$ _____
 Compensation Ins. at \$ _____ per C. \$ _____
 Trucking \$ _____
 Pav't Patch \$ _____
 Tap by Gissord \$ _____
 & Co. 11-4-59. \$ _____
 O'head \$ _____
 \$ _____

~~St.~~
~~Pl.~~
 Webster Ave. No. 21

Name of Owner
 Lynn Chase

Labor and Mat'l. Report Nov. 4 19 59

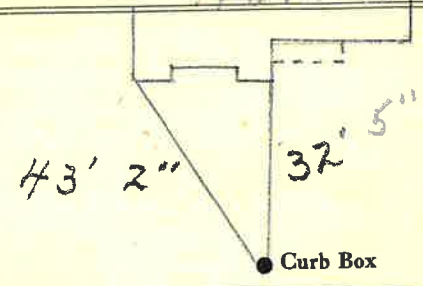

12" Main Elev. of Main at tap 4'

Gate at • Gate at
 3/4" copper 37' to main

• Curb Box
 TAX ID# 302.11-6-14