

LABOR AND MATERIALS

1	Copper Lead	Connection	$\frac{3}{4}$ "	\$	8.08
1	Curb	Cock Valve T.S. & V.	$\frac{3}{4}$ in.	\$	3.89
1	Service box	Short $3\frac{1}{2}$ x $4\frac{1}{2}$	}	\$	4.50
	Old returned	Long $4\frac{1}{2}$ x $5\frac{1}{2}$			
35	Ft.	$\frac{3}{4}$ in. Copper Pipe at	45	\$	15.95
		Nipples	in. at	\$	
		Bushings	to in. at	\$	
		Red'g Inc'g	Coupl'gs to in. at	\$	
		Union	in. at	\$	
		Meter	in. at	\$	
		Lead Joints	at	\$	
		Compound Joints	at	\$	
		Maintenance Foreman		\$	1.384
		Hrs. Water Maint. Man	1 at	\$	
12	Hrs.	Water Maint. Man	2 at 1.613	\$	19.36
14	Hrs.	Garage Foreman	1.62 at 1.481	\$	20.73
26	Hrs.	Labor	at 1.30	\$	33.80
		Hrs. Compressor at		\$	
		Compensation Ins. at	\$ 5.686 per C	\$	4.20
		Trucking		\$	1.50
		Pav't Patch		\$	23.40
		Tap by Gifford & Co.	7-26-56	\$	
		O'head		\$	
				\$	130.03

106.63

Webster


St. Ave. No. 27

Name of Owner

James Young

Labor and Mat'l. Report

July 26 1956

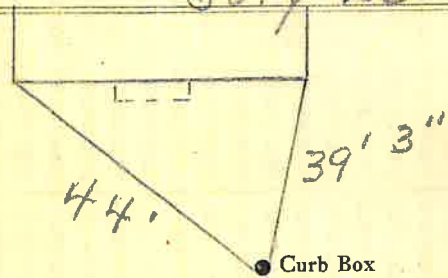

● Curb Box

12" Main

Elev. of Main at tap 4'

Gate at ●

● Gate at

35' to main

● Curb Box

TAX ID# 302.11-6-12