

LABOR AND MATERIALS


Copper	} Connection	-----	\$
Lead		-----	\$
Curb	} Cock Valve T. S. & V.	-----	\$
		-----	\$
Service Box	} Short 3/2x4 1/2 Long 4 1/2x5 1/2 Buff. or Rdway	-----	\$
Old returned		-----	\$
35 Ft. 3/4 in.		-----	\$
(1993)	} Copper Galv Iron Cast Iron	-----	\$
Nipples		-----	\$
Bushings		-----	\$
Red'g Inc'g	} Couplings	-----	\$
		-----	\$
Union	-----	\$	
Meter	-----	\$	
Lead Joints	-----	\$	
Leadite Joints	-----	\$	
Hrs. Foreman	-----	\$	
Hrs. Chauffeur	-----	\$	
Hrs. Tapper	-----	\$	
Hrs. Labor	-----	\$	
Hrs. Labor	-----	\$	
Hrs. Compressor	-----	\$	
Compensation Ins.	-----	\$	
Trucking	-----	\$	
Builders Use of Water	-----	\$	
	-----	\$	
	-----	\$	
St:  
Pl:

Webster Ave. No. 29

Name of Owner  
TAX ID # 302.11-6-11

Labor and Mat'l. Report 7-19-39 19

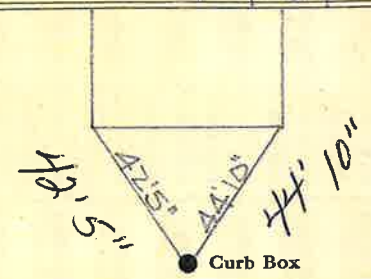

12" Main Elev. of Main at tap  
Gate at ● Gate at ●

35' to main

● Curb Box

L. N. Towne