

LABOR AND MATERIALS


| | | | | | |
|----|------------------------------|-----------------------|---------|---------|------------|
| 1 | Copper | Connection | 3/4 | \$ | 2.87 |
| | Lead | | | | |
| 1 | Curb | Cock Valve T. S. & V. | 3/4 in. | \$ | 3.62 |
| 1 | Service box | Short 3 1/2 X 4 1/2 | | | |
| | Old returned | Long 4 1/2 X 5 1/2 | | | 4.68 |
| | | Buff or Rdway | | | |
| 39 | Ft. | Copper | 3/4 in. | Pipe at | 32 \$10.88 |
| | | G. I. | | | |
| | | C. I. | | | |
| | Nipples | in. at | | \$ | |
| | Bushings | to in. at | | \$ | |
| | Red'g | | | | |
| | Inc'g | Coupl'gs to in. at | | \$ | |
| | Union | in. at | | \$ | |
| | Meter | in. at | | \$ | |
| | Lead Joints | at | | \$ | |
| | Compound Joints | at | | \$ | |
| 1 | Hrs. Water Maint. Man-1 | at | 1.12 | \$ | 1.12 |
| 8 | Hrs. Water Maint. Man-2 | at | 1.02 | \$ | 8.16 |
| 10 | Hrs. Labor | at | .91 | \$ | 9.10 |
| | Hrs. Labor | at | | \$ | |
| 2 | Hrs. Compressor | at | 1.20 | \$ | 2.40 |
| | Compensation Ins. | at \$ 2.18 per C | | \$ | 4.0 |
| | Trucking | | | \$ | 2.00 |
| | Pav't Patch | | | \$ | 10.25 |
| | Tap by H. W. S. / M. S. K. / | | | \$ | |
| | O'head | | | \$ | |
| | | | | \$ | 55.48 |

18

St. ~~St.~~
 Pt. ~~Pt.~~
 Ave. No. 9411
 Webster

Name of Owner
 Griffin Lumber Co

Labor and Mat'l. Report Aug 23 1949

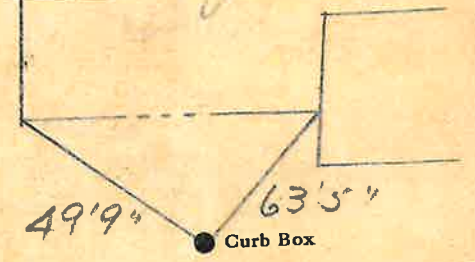

12 Main Elev. of Main at tap 4 1/2

Gate at ● Gate at ●
 3/4" copper 34' to main

● Curb Box

TAX ID # 302.11-6-19