


Labor and Materials

| | | | | |
|-------|-----------------------|-----------------------------|-------------|----------|
| 1 | Copper | Connection | 3 | \$ 1.48 |
| 1 | Lead | | 1 | |
| 1 | Curb | Cock Valve T.S.&V. | 3/4 in | \$ 1.79 |
| 1 | Service Box | Short 3 1/2 x 4 1/2 | | \$ 1.30 |
| | Old returned | Long 4 1/2 x 5 1/2 | | |
| | | Buff. or Rdway | | |
| 10 | Ft. | Copper Galv. Iron Cast Iron | Pipe at 3/4 | \$ 1.80 |
| | Nipples | in. at | | \$ |
| | Bushings | to in. at | | \$ |
| | Red'g Inc'g | Couplings | to in. at | \$ |
| | Union | in. at | | \$ |
| | Meter | in. at | | \$ |
| | Lbs. Br. Stone | at | | \$ |
| | Lbs. Sand | at | | \$ |
| | Bags Cement | at | | \$ |
| | Paving Brick | Mack Red Asphalt | at | \$ |
| | Lead Joints | at | | \$ |
| | Leadite Joints | at | | \$ |
| 3 | Hrs. | Foreman | at | \$ 1.88 |
| 4 | Hrs. | Common Labor | at | \$ 1.80 |
| | Hrs. | Common Labor | at | \$ |
| | Hrs. | Mason | at | \$ |
| | Hrs. | Masons Helper | at | \$ |
| | Hrs. | Compressor | at | \$ |
| | Compensation Ins | | | \$ 1.2 |
| | Trucking | | | \$ 1.00 |
| | Builders Use of Water | | | \$ 2.50 |
| Total | | | | \$ 13.67 |

32-124
Labor and Material Report

Oct 13 1932

24 Webster Ave

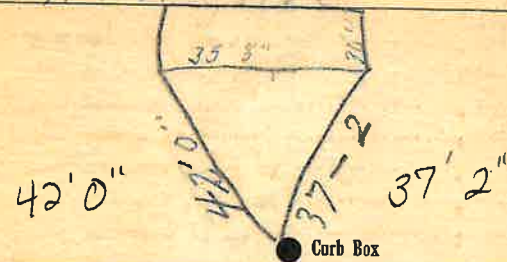

TAX ID# 302.11-4-10

12 Main

Elev. of Main at tap 4

Gate at ● 10' to MAIN ● Gate at

● Curb Box

New House

S.M. Shapera

C.R. [Signature]