

LABOR AND MATERIALS


Copper } Connection ----- \$  
 Lead }  
 Curb { Cock } ----- in. \$  
       { Valve }  
       { T. S. & V. }  
 Service Box { Short 3 1/2 x 4 1/2 } ----- \$  
 Old returned { Long 4 1/2 x 5 1/2 }  
               { Buff. or Rdway }  
 Ft. ----- in. { Copper } Pipe at ----- \$  
                   { Galv Iron }  
                   { Cast Iron }  
 Nipples ----- in. at ----- \$  
 Bushings ----- to ----- in. at ----- \$  
 Red'g } Couplings ----- to ----- in. at ----- \$  
 Inc'g }  
 Union ----- in. at ----- \$  
 Meter ----- in. at ----- \$  
 Lead Joints at ----- \$  
 Leadite Joints at ----- \$  
 Hrs. Foreman at ----- \$  
 Hrs. Chauffeur at ----- \$  
 Hrs. Tapper at ----- \$  
 Hrs. Labor at ----- \$  
 Hrs. Labor at ----- \$  
 Hrs. Compressor at ----- \$  
 Compensation Ins. ----- \$  
 Trucking ----- \$  
 Builders Use of Water ----- \$  
 ----- \$  
 ----- \$  
St.  
 Pl.

Webster Ave. No. 39

Name of Owner  
 J. B. Hartman

Labor and Mat'l. Report 7-19-39 19

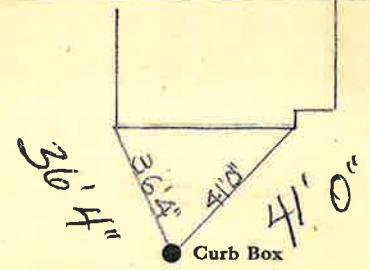

TAX ID # 302.11-6-6

Main Elev. of Main at tap  
 Gate at ● Gate at ●

● Curb Box