

## LABOR AND MATERIALS

1	Copper Lead	Connection	3/4		\$ 2.87
1	Curb	Cock Valve T. S. & V.	3/4	in.	\$ 3.62
	Service box Old returned	Short 3 1/2 X 4 1/2 Long 4 1/2 X 5 1/2 Buffer Rdway			\$ 4.68
9	Ft. in.	Copper G.I. C.I. Pipe at	32		\$ 2.88
	Nipples	in. at			\$
	Bushings	to in. at			\$
	Red'g Inc'g	Coupl'gs to in. at			\$
	Union	in. at			\$
	Meter	in. at			\$
	Lead Joints	at			\$
	Compound Joints	at			\$
	Hrs. Water Maint. Man-1	at			\$
4	Hrs. Water Maint. Man-2	at	1.02		\$ 4.08
14	Hrs. Labor-	at	91		\$ 12.74
	Hrs. Labor-	at			\$
3	Hrs. Compressor	at	1.20		\$ 3.60
	Compensation Ins.	at \$ 2.18 per C.			\$ .37
	Trucking				\$ 2.00
	Pav't Patch				\$ 10.25
	<i>Top by Warr. metal</i>				\$
					\$
					\$
	O'head				\$
					\$ 47.09

27

*Webster*


St-  
Pl-  
Ave. No. 90

Name of Owner

*Jones*

Labor and Mat'l. Report

*May 9* 19*49*

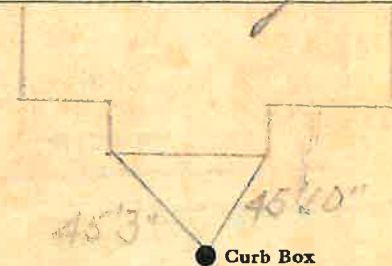

*12* Main

Elev. of Main at tap *3*

Gate at ● ● Gate at

*9' to main*

● Curb Box

TAX ID# 302.11-4-11