

LABOR AND MATERIALS

1	Copper Lead	{ Connection	$\frac{3}{4}$	-----	\$ 1.23
1	Curb	{ Cock Valve T.S. & V.	$\frac{3}{4}$ in.	-----	\$ 1.68
1	Service Box Old returned	{ Short $3\frac{1}{2} \times 4\frac{1}{2}$ Long $4\frac{1}{2} \times 5\frac{1}{2}$ Buff. or Rdway		-----	\$ 1.54
36	Ft. $\frac{3}{4}$ in.	{ Copper Galv Iron Cast Iron	Pipe at	17	\$ 6.12
	Nipples	in. at			\$
	Bushings	to in. at			\$
	Red'g Inc'g	{ Couplings	to in. at		\$
	Union	in. at			\$
	Meter	in. at			\$
	Lead Joints	at			\$
	Leadite Joints	at			\$
	Hrs. Foreman	at			\$
7	Hrs. Chauffeur	at	62 hr		\$ 1.25
8	Hrs. Tapper	at			\$ 5.00
8	Hrs. Labor	at	45		\$ 3.60
	Hrs. Labor	at			\$
	Hrs. Compressor	at			\$
	Compensation Ins.				\$ .30
	Trucking				\$ 1 -
	Builders Use of Water				\$
	Taphy Hessel				\$
	Patch 1/2 Sewer Dept				\$ 2.50
					\$
					\$ 24.22

17 - 1939

St.


Webster Ave No. 45

Name of Owner

LaRouche

Labor and Mat'l. Report

May 8 1939

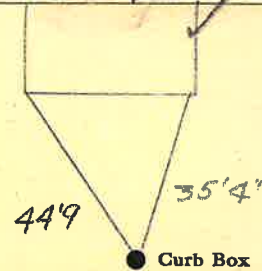

● Curb Box

12 Main

Elev. of Main at tap 4'

Gate at ●

● Gate at

36' to main

● Curb Box

10/22 not on map

New Tap