


St. 10 Webster
Pl. # _____
Ave. No. _____

Name of Owner _____

Labor and Mat'l. Report 19

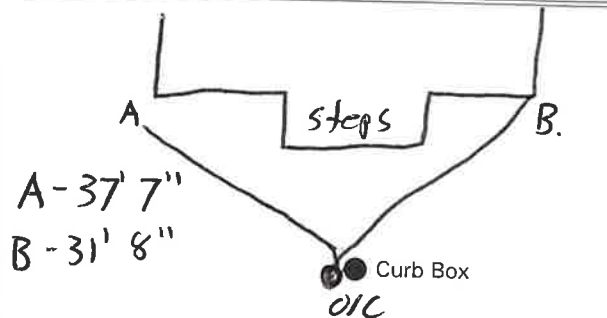

_____ Main Elev. of Main at tap _____

Gate at ● Gate at ●

● Curb Box


St. _____
Pl. # _____
Ave. No. 10

Webster

Name of Owner _____

Emery White

Labor and Mat'l. Report Mar. 17 1964

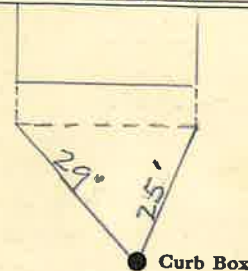

12" Main

Elev. of Main at tap 4'

Gate at ● Gate at ●

3/4" copper 10' to main

● Curb Box

Emery White

TAX ID # 302.11-3-22

LABOR AND MATERIALS

Copper } Connection _____ \$ _____
 Lead }
 Curb } Cock Valve } _____ in. _____ \$ _____
 } T.S. & V. }
 Service box { Short 3-1/2 x 4-1/2 } _____ \$ _____
 Old returned { Long 4-1/2 x 5-1/2 }
 Ft. _____ in. { Copper } Pipe at _____ \$ _____
 } G.I. }
 } C.I. }
 Nipples _____ in. at _____ \$ _____
 Bushings _____ to _____ in. at _____ \$ _____
 Red'g _____
 Inc'g _____
 Union _____ in. at _____ \$ _____
 Meter _____ in. at _____ \$ _____
 _____ \$ _____
 Compound Joints at _____ \$ _____
 Maintenance Foreman _____ \$ _____
 Hrs. Water Maint. Man - 1 at _____ \$ _____
 Hrs. Water Maint. Man - 2 at _____ \$ _____
 Hrs. Garage Foreman _____ at _____ \$ _____
 Hrs. Labor _____ at _____ \$ _____
 Hrs. Compressor at _____ \$ _____
 _____ \$ _____
 Trucking _____ \$ _____
 Pav't Patch _____ \$ _____
 _____ \$ _____
 _____ \$ _____
LABOR AND MATERIALS

1 Copper } Connection 3/4" _____ \$ _____
 Lead }
 1 Curb } Cock Valve } 3/4 Oriseal in. _____ \$ _____
 } T.S. & V. }
 1 Service Box { Short 3 1/2 x 4 1/2 } _____ \$ _____
 Old returned { Long 4 1/2 x 5 1/2 }
 { Buff. or Rdway }
 10 Ft. 3/4 in. { Copper } Pipe at _____ \$ _____
 } Galv Iron }
 } Cast Iron }
 Nipples _____ in. at _____ \$ _____
 Bushings _____ to _____ in. at _____ \$ _____
 Red'g } Couplings _____ to _____ in. at _____ \$ _____
 Inc'g }
 Union _____ in. at _____ \$ _____
 Meter _____ in. at _____ \$ _____
 Lead Joints at _____ \$ _____
 Leadite Joints at _____ \$ _____
 Hrs. Foreman at _____ \$ _____
 Hrs. Chauffeur at _____ \$ _____
 Hrs. Tapper at _____ \$ _____
 Hrs. Labor at _____ \$ _____
 Hrs. Labor at _____ \$ _____
 Hrs. Compressor at _____ \$ _____
 Compensation Ins. _____ \$ _____
 Trucking _____ \$ _____
 Builders Use of Water _____ \$ _____
 Tap by Gifford & Co. _____ \$ _____
 3-17-64. _____ \$ _____
 Tap on side of _____ \$ _____
 main