

### LABOR AND MATERIALS


1	Copper	Connection	3/4			\$ 2.87
	Lead					
1	Curb	Cock Valve	3/4	in.		\$ 3.62
		T. S. & V.				
1	Service box	Short 3 1/2 X 4 1/2				
	Old returned	Long 4 1/2 X 5 1/2				\$ 4.68
		Buff or Rdway				
33	Ft.	Copper	3	in.	Pipe at	\$ 10.56
		G.I.				
		G.I.				
	Nipples	in. at				\$
	Bushings	to in. at				\$
	Red'g					
	Inc'g	Coupl'gs to in. at				\$
	Union	in. at				\$
	Meter	in. at				\$
	Lead Joints	at				\$
	Compound Joints	at				\$
2	Hrs. Water Maint. Man-1	at	1.42			\$ 2.24
3	Hrs. Water Maint. Man-2	at	1.02			\$ 3.06
1.4	Hrs. Labor-	at	91			\$ 12.74
	Hrs. Labor-	at				\$
1	Hrs. Compressor at		1.20			\$ 1.20
	Compensation Ins. at \$ 2.18. per C.					\$ 3.9
	Trucking					\$ 2.07
	Pav't Patch					\$ 10.25
	Top by W. W. S. S. S. S. S.					\$
						\$
						\$
	O'head					\$
						\$ 53.61

4

St. Webster  
Ave. No. 57

Name of Owner  
Caputo

Labor and Mat'l. Report Opri 29 1949

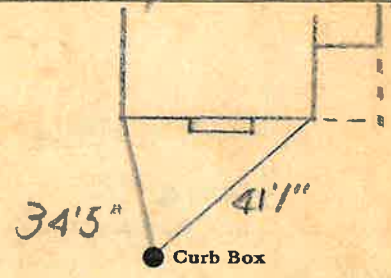

12 Main Elev. of Main at tap 3'

Gate at ● Gate at ●

33' to MAIN

● Curb Box

TAX ID # 302.12-17-15