

### LABOR AND MATERIALS

Copper	Lead	Connection	3/4		\$ 2.87
Curb	Valve	T. S. & V.	3/4 in.		\$ 3.62
Service box	Old returned	Short	3/2 X 4 1/2		\$ 4.68
11 Ft. 3/4 in.	Pipe at	Copper	32		\$ 3.52
		G. I.			
		C. I.			
Nipples	in. at				\$
Bushings	to	in. at			\$
Red'g					\$
Inc'g	Coupl'gs	to	in. at		\$
Union	in. at				\$
Meter	in. at				\$
Lead Joints at					\$
Compound Joints at					\$
Hrs. Water Maint. Man-1	at				\$
7 Hrs. Water Maint. Man-2	at	1.02			\$ 7.14
2.5 Hrs. Labor	at	9.1			\$ 22.75
Hrs. Labor	at				\$
Hrs. Compressor at					\$
Compensation Ins.	at \$ 2.18 per C				\$ 1.65
Trucking					\$ 2.00
Pav't Patch					\$ 10.25
<i>Tap by M. G. P. 11/1/44</i>					
O'head					\$
					\$ 57.48

107

-St-  
-Pl-  
Ave. No. 60

*Webster*


Name of Owner

*Conde*

Labor and Mat'l. Report

*Oct 4*

1949

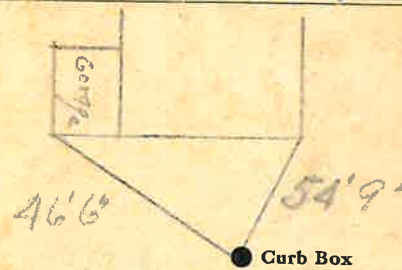

*12* Main

Elev. of Main at tap *3*

Gate at ●

● Gate at

*11' to main*

● Curb Box

TAX ID# 302.12-2-1D