

97-1937

KH 6-6-2001 62

Webster


St. ~~64~~  
Pt. ~~46~~  
Ave. No. ~~46~~

Name of Owner

Specton N LAMBKIN

Labor and Mat'l. Report

Sept 9 1987

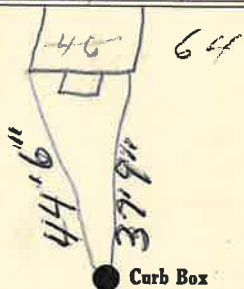

12" Main

Elev. of Main at tap 4 1/2

Gate at ●

11' to main

● Gate at

● Curb Box

New House

TH

WEBSTER


St. ~~64~~  
Pt. ~~46~~  
Ave. No. 62

Name of Owner

TAX ID # 302.12-2-11 KH

Labor and Mat'l. Report

6-1-2001

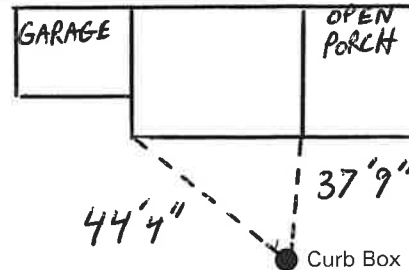

12" Main

Elev. of Main at tap 3

Gate at ●

● Gate at

7' 4" to main

● Curb Box

