

LABOR AND MATERIALS


Copper	Lead	Connection	3/4		\$ 2.87	
	Curb	Cock Valve T. S. & V.	3/4	in.	\$ 3.62	
	Service box Old returned	Short 3/4 X 1/2 Long 4 1/2 X 5 1/2 Buff or Rdway			\$ 4.68	
10 Ft.	3/4	in.	Copper C. I. C. I.	Pipe at 32	\$ 3.20	
Nipples	in.	at			\$	
Bushings	to	in.	at	\$		
Red'g	Inc'g	Coup'gs	to	in.	at	\$
Union	in.	at			\$	
Meter	in.	at			\$	
Lead Joints	at				\$	
Compound Joints	at				\$	
6 Hrs.	Water Maint. Man-1	at			\$	
18 Hrs.	Water Maint. Man-2	1.02	at		\$ 6.12	
18 Hrs.	Labor	91	at		\$ 16.38	
Hrs.	Labor	at			\$	
Hrs.	Compressor	at			\$	
Compensation Ins.	at \$ 2.18 per C				\$ 4.9	
Trucking					\$ 2.00	
Pav't Patch					\$ 10.25	
Tap					\$	
O'head					\$	
					\$ 49.61	

111

St. _____
Pl. _____
Ave. No. 68

Name of Owner
Hardley

Labor and Mat'l. Report Oct 14 1949

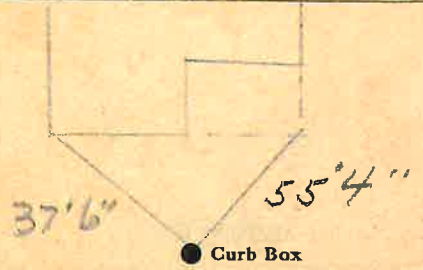

12 Main Elev. of Main at tap 6'
Gate at ● Gate at ●

10' to main

● Curb Box

TAX ID # 302.12-2-13