

2.47 Lot-7

Webster Ave. No. 71

Name of Owner TAX ID  
Jones # 302.12-17-11

Labor and Mat'l. Report July 21 1948

38'7"  
44'6"  
37'2"  
Cellarwall  
Curb Box

12 Main Elev. of Main at tap 5

Gate at Gate at

33' to main




Curb Box

Renewal Tap 7-1-91  
Copper

LSM-5C 3 13-48

# Iron Clad Portland Cement

VELO HIGH-EARLY - IRON CLAD MASONRY CEMENT

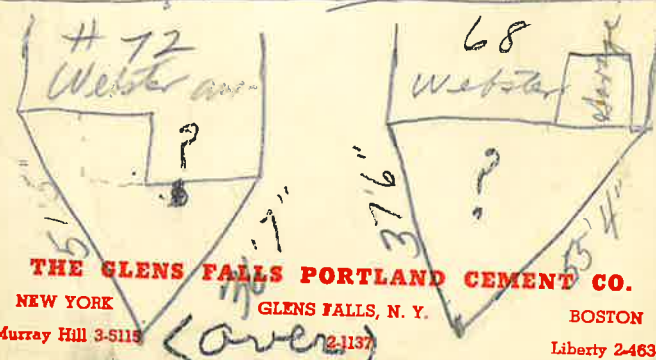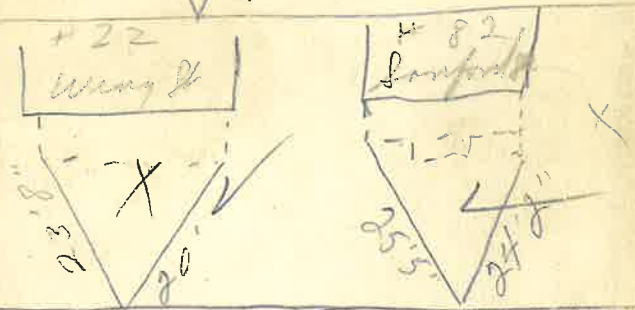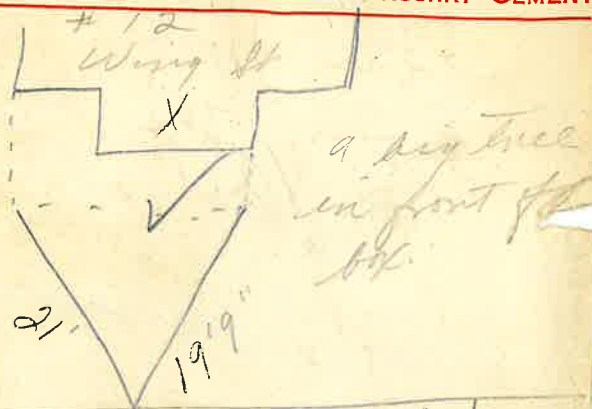

THE GLENS FALLS PORTLAND CEMENT CO.

NEW YORK      GLENS FALLS, N. Y.      BOSTON  
Murray Hill 3-5115      (over) 2-1137      Liberty 2-4634

## LABOR AND MATERIALS

1	Copper Lead	Connection	3/4		\$ 2.94
1	Curb	Cock Valve	3/4 in.		\$ 3.71
1	Service box	Short 3/4 X 4 1/2			\$ 5.90
1	Old returned	Long 4 1/2 X 5 1/2			
33	Ft.	3/4 in. Copper		Pipe at 30	\$ 9.90
		G. I.			
		G. I.			
	Nipples		in. at		\$
	Bushings		to in. at		\$
	Red'g				
	Inc'g	Coupl'gs	to in. at		\$
	Union		in. at		\$
	Meter		in. at		\$
	Lead Joints		at		\$
	Compound Joints		at		\$
3/4	Hrs. Water Maint. Man-1		at 1.01		\$ 76
5	Hrs. Water Maint. Man-2		at .91		\$ 4.55
22	Hrs. Labor		at .80		\$ 17.60
	Hrs. Labor		at		\$
3/4	Hrs. Compressor		at 1.20		\$ 90
	Compensation Ins.		at \$ per C		\$ .57
	Trucking				\$ 1.57
	Pav't Patch				\$ 20.70
	Tap by McGovern				\$
	O'head				\$
					\$ 68.47