


LABOR AND MATERIALS

Copper } Connection _____	\$ _____
Lead } _____	\$ _____
Curb } Cock Valve } _____ in.	\$ _____
} T. S. & V. }	
Service box } Short 3½ x 4½ }	\$ _____
Old returned } Long 4½ x 5½ }	
} Buff or Rdway }	
Ft. _____ in. } Copper } Pipe at _____	\$ _____
} G. I. ? }	
} C. I. }	
Nipples _____ in. at _____	\$ _____
Bushings _____ to _____ in. at _____	\$ _____
Red'g } Coupl'gs _____ to _____ in. at _____	\$ _____
Inc'g }	
Union _____ in. at _____	\$ _____
Meter _____ in. at _____	\$ _____
Lead Joints at _____	\$ _____
Compound Joints at _____	\$ _____
Maintenance Foreman _____	\$ _____
Hrs. Water Maint. Man—1 at _____	\$ _____
Hrs. Water Maint. Man—2 at _____	\$ _____
Hrs. Garage Foreman _____ at _____	\$ _____
Hrs. Labor _____ at _____	\$ _____
Hrs. Compressor at _____	\$ _____
Compensation Ins. at \$ _____ per C _____	\$ _____
Trucking _____	\$ _____
Pav't Patch _____	\$ _____
Measured in by _____	\$ _____
Barrett Lashway _____	\$ _____
5-12-69 _____	\$ _____
O'head _____	\$ _____
_____	\$ _____

St. \_\_\_\_\_  
 PL. \_\_\_\_\_  
 Ave. No. 72

Name of Owner \_\_\_\_\_  
 TAX ID # 302.12-2-14

Measured in \_\_\_\_\_  
 Labor and Mat'l. Report May 12 1969

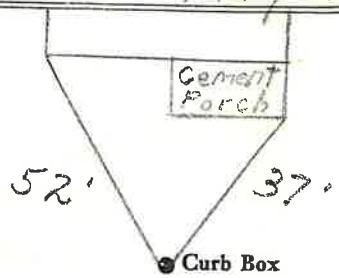

12" Main                      Elev. of Main at tap 5'

Gate at ●    ● Gate at

● Curb Box