


St. 12 Webster
Pl.
Ave. No.

Name of Owner


Labor and Mat'l. Report 19

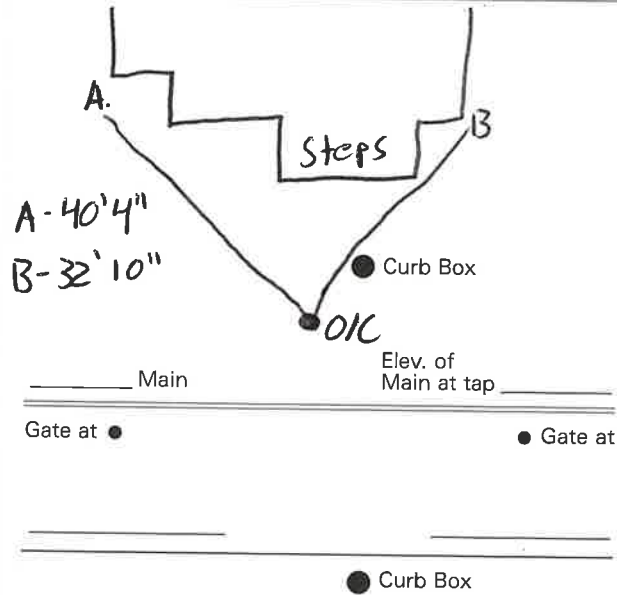

Labor and Material Report

19 29

12 Webster Ave

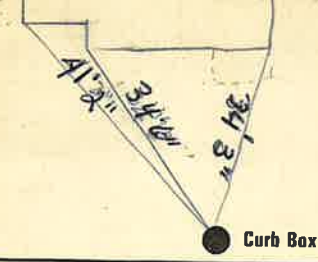

12 Main

Elev of Main at tap 45

Gate at ●
3/4 copper

● Gate at
9' to main

● Curb Box

McGee

TAX ID# 302.11-3-23

LABOR AND MATERIALS

_____	Copper } Connection	_____	\$ _____
_____	Lead } _____		
_____	Curb } Cock	_____ in.	\$ _____
	Valve } _____		
	T.S. & V. } _____		
_____	Service box { Short 3-1/2 x 4-1/2 }	_____	\$ _____
_____	Old returned { Long 4-1/2 x 5-1/2 }	_____	\$ _____
_____	Ft. _____ in. { Copper } Pipe at _____		\$ _____
		{ G.I. }	
		{ C.I. }	
_____	Nipples _____ in. at _____		\$ _____
_____	Bushings _____ to _____ in. at _____		\$ _____
_____	Red'g _____		\$ _____
_____	Inc'g _____		\$ _____
_____	Union _____ in. at _____		\$ _____
_____	Meter _____ in. at _____		\$ _____
_____	_____		\$ _____
_____	Compound Joints at _____		\$ _____
_____	Maintenance Foreman _____		\$ _____
_____	Hrs. Water Maint. Man - 1 at _____		\$ _____
_____	Hrs. Water Maint. Man - 2 at _____		\$ _____
_____	Hrs. Garage Foreman _____ at _____		\$ _____
_____	Hrs. Labor _____ at _____		\$ _____
_____	Hrs. Compressor at _____		\$ _____
_____	_____		\$ _____
_____	Trucking _____		\$ _____
_____	Pav't Patch _____		\$ _____
_____	_____		\$ _____
_____	_____		\$ _____
Labor and Materials

1	Copper } Connection	_____	\$ 2.60
	Lead } _____		
1	Curb } Cock	_____ in.	\$ 2.30
	Valve } _____		
	T.S. & V. } _____		
1	Service Box { Short 3-1/2 x 4-1/2 }	_____	\$ 1.50
	Old returned { Long 4-1/2 x 5-1/2 }	_____	
		{ Buff. or Rdway }	
9	Ft. _____ in. { Copper } Pipe at _____		\$ 2.89
		{ Cast Iron }	
		{ Cast Iron }	
_____	Nipples _____ in. at _____		\$ _____
_____	Bushings _____ to _____ in. at _____		\$ _____
_____	Red'g } Couplings	_____ to _____ in. at _____	\$ _____
	Inc'g } _____		
_____	Union _____ in. at _____		\$ _____
_____	Meter _____ in. at _____		\$ _____
_____	Lbs. Br. Stone at _____		\$ _____
_____	Lbs. Sand at _____		\$ _____
_____	Bags Cement at _____		\$ _____
_____	Paving Brick { Mack } at _____		\$ _____
	Red } _____		
	Asphalt } _____		
_____	Lead Joints at _____		\$ _____
_____	Leadite Joints at _____		\$ _____
2	Hrs. Foreman at _____		\$ 1.25
2	Hrs. Common Labor at _____		\$ 8.1
_____	Hrs. Common Labor at _____		\$ _____
_____	Hrs. Mason at _____		\$ _____
_____	Hrs. Mason's Helper at _____		\$ _____
_____	Hrs. Compressor at _____		\$ _____
_____	Compensation Ins _____		\$ 0.5
_____	Trucking _____		\$ 1.00
_____	Builders' Use of Water Patch _____		\$ 5.00
Total \$			16.90