

LABOR AND MATERIALS


1	Copper Lead	Connection	3/4	\$	2.94
1	Curb	Cock Valve T. S. & V.	3/4 in.	\$	3.71
1	Service box Old returned	Short 3 1/2 X 4 1/2 Long 4 1/2 X 5 1/2 Buff or Rdway		\$	5.90
31	Ft. 3/4 in.	Copper C-I C-I	Pipe at 30	\$	9.30
	Nipples	in. at		\$	
	Bushings	to in. at		\$	
	Red'g			\$	
	Inc'g	Coupl'gs to in. at		\$	
	Union	in. at		\$	
	Meter	in. at		\$	
	Lead Joints	at		\$	
	Compound Joints	at		\$	
3/4	Hrs. Water Maint. Man-1	at	1.01	\$	76.75
5	Hrs. Water Maint. Man-2	at	91	\$	4.55
2 1/2	Hrs. Labor	at	80	\$	16.80
	Hrs. Labor	at		\$	
3/4	Hrs. Compressor	at	1.20	\$	90
	Compensation Ins.	at \$ per C		\$	49
	Trucking			\$	1
	Pav't Patch			\$	20.70
	Tap by M. J. [unclear]			\$	
	O'head			\$	
				\$	67.05

8-47

St. _____
Pl. _____
Ave. No. 73

Name of Owner
Jones

Labor and Mat'l. Report July 21 1948

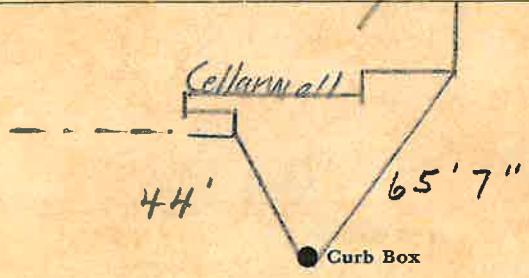

12 Main Elev. of Main at tap 5

Gate at ● ● Gate at

31' to main

● Curb Box

TAX ID # 302.12-17-10