

116 - 1940


Webster

St. #76  
Pl. lot 85  
Ave. No.

Name of Owner

Jones

Labor and Mat'l. Report Oct 10 1940

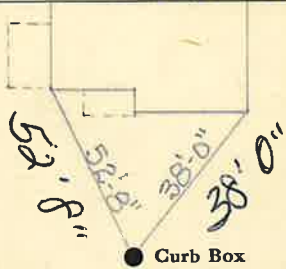

12 Main

Elev. of Main at tap 4 1/2

Gate at ●

● Gate at

13' to MAIN

● Curb Box

113 1942


Webster

St. 74 -  
Pl. 76  
Ave. No.

Name of Owner

Marvin Savetts

Labor and Mat'l. Report Jan 20 1942

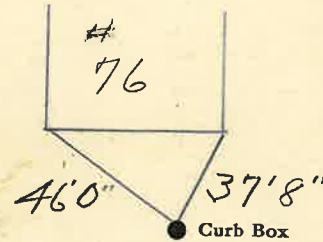

12 Main

Elev. of Main at tap 4

Gate at ●

● Gate at

12' to MAIN

● Curb Box

TAX ID # 302.12-2-15

### LABOR AND MATERIALS

|                       |                       |                             |            |          |
|-----------------------|-----------------------|-----------------------------|------------|----------|
| 1 Copper Lead         | Connection            | 3/4                         |            | \$ 1.31  |
| 1 Curb                | Cock Valve T. S. & V. | 3/4                         | in.        | \$ 1.75  |
| 1 Service Box         | Old returned          | Short 3/2x4 1/2             |            | \$ 1.60  |
|                       |                       | Long 4 1/2x5 1/2            |            |          |
| 13 Ft. 3/4 in.        |                       | Copper Galv. Iron Cast Iron | Pipe at 18 | \$ 2.34  |
| Nipples               | in. at                |                             |            | \$       |
| Bushings              | to in. at             |                             |            | \$       |
| Red'g Inc'g           | Couplings             | to in. at                   |            | \$       |
| Union                 | in. at                |                             |            | \$       |
| Meter                 | in. at                |                             |            | \$       |
| Lead Joints           | at                    |                             |            | \$       |
| Leadite Joints        | at                    |                             |            | \$       |
| Hrs. Foreman          | at                    |                             |            | \$       |
| 3 Hrs. Chauffeur      | at                    | 6 1/2                       |            | \$ 1.98  |
| Hrs. Tapper           | at                    |                             |            | \$       |
| 7 Hrs. Labor          | at                    | 45                          |            | \$ 3.15  |
| Hrs. Labor            | at                    |                             |            | \$       |
| Hrs. Compressor       | at                    |                             |            | \$       |
| Compensation Ins.     |                       |                             |            | \$ 16    |
| Trucking              |                       |                             |            | \$ 1     |
| Builders Use of Water | Patch (Sewer)         |                             |            | \$ 2.50  |
| Twp by Penon          |                       |                             |            | \$       |
|                       |                       |                             |            | \$       |
|                       |                       |                             |            | \$       |
|                       |                       |                             |            | \$       |
|                       |                       |                             |            | \$       |
|                       |                       |                             |            | \$ 15.69 |

### LABOR AND MATERIALS

|                       |                       |                             |            |          |
|-----------------------|-----------------------|-----------------------------|------------|----------|
| 1 Copper Lead         | Connection            | 3/4                         |            | \$ 1.35  |
| 1 Curb                | Cock Valve T. S. & V. | 3/4                         | in.        | \$ 1.88  |
| 1 Service Box         | Old returned          | Short 3/2x4 1/2             |            | \$ 1.82  |
|                       |                       | Long 4 1/2x5 1/2            |            |          |
| 12 Ft. 3/4 in.        |                       | Copper Galv. Iron Cast Iron | Pipe at 20 | \$ 2.40  |
| Nipples               | in. at                |                             |            | \$       |
| Bushings              | to in. at             |                             |            | \$       |
| Red'g Inc'g           | Couplings             | to in. at                   |            | \$       |
| Union                 | in. at                |                             |            | \$       |
| Meter                 | in. at                |                             |            | \$       |
| Lead Joints           | at                    |                             |            | \$       |
| Leadite Joints        | at                    |                             |            | \$       |
| Hrs. Foreman          | at                    |                             |            | \$       |
| 3 Hrs. Chauffeur      | at                    | sp @ 55                     |            | \$ 16.5  |
| 2 Hrs. Tapper         | at                    | 68 3/4                      |            | \$ 5.50  |
| 8 Hrs. Labor          | at                    | .55                         |            | \$ 4.40  |
| Hrs. Labor            | at                    |                             |            | \$       |
| 5 Hrs. Compressor     | at                    | 92                          |            | \$ 4.50  |
| Compensation Ins.     |                       |                             |            | \$ .36   |
| Trucking              |                       |                             |            | \$ 1.00  |
| Builders Use of Water | Patch (S)             |                             |            | \$ 2.50  |
| Twp by Hessel         |                       |                             |            | \$       |
|                       |                       |                             |            | \$       |
|                       |                       |                             |            | \$       |
|                       |                       |                             |            | \$       |
|                       |                       |                             |            | \$       |
|                       |                       |                             |            | \$ 27.46 |

St.