

LABOR AND MATERIALS


1	Copper Lead	Connection		\$	
1	Curb	Cock Valve T.S. & V.	in.	\$	
1	Service box Old returned	{ Short 3½ x 4½ Long 4½ x 5½ Buff or Rdway }		\$	
30 +	Ft. in.		Copper G.I. C.I.	Pipe at	\$
	Nipples	in. at		\$	
	Bushings	to in. at		\$	
	Red'g Inc'g	Coupl'gs	to in. at	\$	
	Union	in. at		\$	
	Meter	in. at		\$	
	Lead Joints	at		\$	
	Compound Joints	at		\$	
	Maintenance Foreman			\$	
	Hrs. Water Maint. Man	1 at		\$	
	Hrs. Water Maint. Man	2 at		\$	
	Hrs. Garage Foreman	at		\$	
	Hrs. Labor	at		\$	
	Hrs. Compressor	at		\$	
	Compensation Ins.	at \$	per C	\$	
	Trucking			\$	
	Pav't Patch			\$	
	O'head			\$	

St. _____
Pl. _____
Ave. No. 75

Name of Owner _____
TAX ID # 302.12-17-9

Installed in 1964.

Labor and Mat'l. Report 19

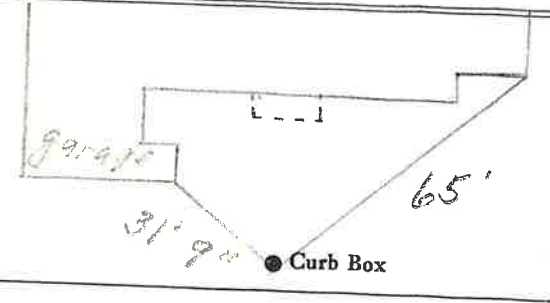

12" Main Elev. of Main at tap 4 1/2

Gate at ● ● Gate at

30' to MAIN

● Curb Box