

109 - 1940

St. ~~_____~~
Pl. ~~_____~~
Ave. No. ~~_____~~


Webster

Name of Owner

OWNER
C. Jones (WALKER)

Labor and Mat'l. Report

Sept 17 1940

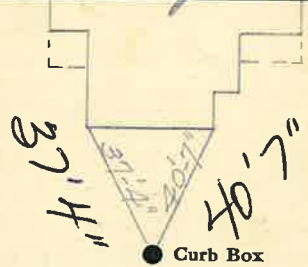

12 Main

Elev. of Main at tap 5-

Gate at ●

● Gate at

12' to main

● Curb Box

46

St. _____
Pl. _____
Ave. No. _____

Name of Owner

78 WEBSTER

Labor and Mat'l. Report 19



11' Main

Elev. of Main at tap _____

Gate at ●

● Gate at

TAX ID# 302.12-2-16

● Curb Box

