


WEBSTER

St. Pl. Ave. No. 82

Name of Owner

Labor and Mat'l. Report 10/16/07

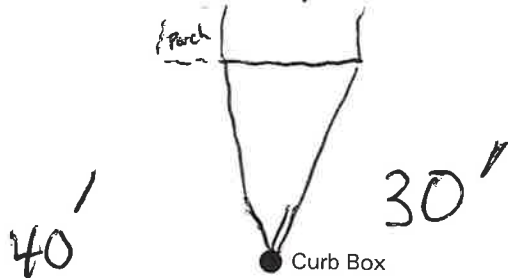

Main Elev. of Main at tap

Gate at Gate at

TAX ID # 302.12-2-17

Curb Box

110 - 1940

St. Pl. Ave. No. 82 #82 4090

Name of Owner

A Jones

Labor and Mat'l. Report Sept 17 1940



12 Main Elev. of Main at tap 5-

Gate at Gate at

12' to main

Curb Box

HA

