


LABOR AND MATERIALS

_____	Copper } Connection	_____	\$ _____
_____	Lead } _____	_____	\$ _____
_____	Curb } Cock	_____ in.	\$ _____
_____	} Valve	_____	\$ _____
_____	} T.S. & V.	_____	\$ _____
_____	Service box { Short 3-1/2 x 4-1/2	_____	\$ _____
_____	Old returned { Long 4-1/2 x 5-1/2	_____	\$ _____
_____	Ft. 2" in. { Copper	_____	\$ _____
_____	} G.I.	_____	\$ _____
_____	} P.C.P.	_____	\$ _____
_____	Nipples _____ in. at _____	_____	\$ _____
_____	Bushings _____ to _____ in. at _____	_____	\$ _____
_____	Red'g _____	_____	\$ _____
_____	Inc'g _____	_____	\$ _____
_____	Union _____ in. at _____	_____	\$ _____
_____	Meter _____ in. at _____	_____	\$ _____
_____	_____	_____	\$ _____
_____	Compound Joints at _____	_____	\$ _____
_____	Maintenance Foreman _____	_____	\$ _____
_____	Hrs. Water Maint. Man - 1 at _____	_____	\$ _____
_____	Hrs. Water Maint. Man - 2 at _____	_____	\$ _____
_____	Hrs. Garage Foreman _____ at _____	_____	\$ _____
_____	Hrs. Labor _____ at _____	_____	\$ _____
_____	Hrs. Compressor at _____	_____	\$ _____
_____	_____	_____	\$ _____
_____	Trucking _____	_____	\$ _____
_____	Pav't Patch _____	_____	\$ _____
_____	_____	_____	\$ _____
_____	_____	_____	\$ _____
_____	_____	_____	\$ _____
_____	_____	_____	\$ _____

WEBSTER St. Pl. Ave. No. 83

Name of Owner
WEBSTER AVE, LIFT STATION

Labor and Mat'l. Report 18 6/24/2010

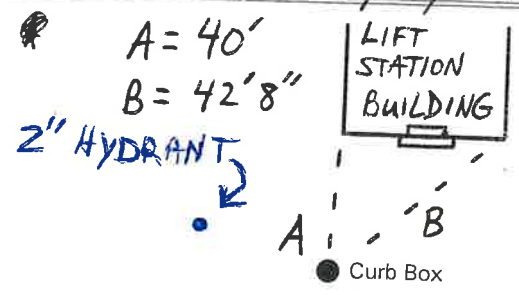

12" Main Elev. of Main at tap 5'6"

Gate at ● ● Gate at

CURB BOX IS COVERED WITH A GATE VALVE COVER.

TAXID # 302.12-17-5 ● Curb Box

47' OF POLYETHYLENE PIPE TO THE MAIN.

HAS TRACING WIRE ON ALL POLY. PIPE