


LABOR AND MATERIALS

1	Copper	} Connection	3/4"	\$	2.94
	Lead				
1	Curb	} Cock Valve T.S. & V.	3/4 in.	\$	3.71
1	Service box	} Short 3 1/2 x 4 1/2 Long 4 1/2 x 5 1/2 Buff or Rdway		\$	5.90
	Old returned				
12	Ft. 3/4 in.	} Copper G.I. C.I.	} Pipe at 30	\$	3.60
	Nipples	in. at		\$	
	Bushings	to in. at		\$	
	Red'g } Inc'g }	Coupl'gs	to in. at	\$	
	Union	in. at		\$	
	Meter	in. at		\$	
	Lead Joints	at		\$	
	Compound Joints	at		\$	
	Maintenance Foreman			\$	
1	Hrs. Water Maint. Man-1	at 1.12		\$	1.12
6	Hrs. Water Maint. Man-2	at 1.02		\$	6.12
	Hrs. Garage Foreman	at 91		\$	5.46
6	Hrs. Labor	at		\$	
1	Hrs. Compressor	at		\$	1.20
	Compensation Ins. at \$	per C.		\$	.28
	Trucking			\$	10.0
	Pav't Patch			\$	6.79
	Tap by Miller			\$	
				\$	
				\$	
	O'head			\$	
				\$	

Webster St. Pl. Ave. No. 88

Name of Owner Butterfield

Labor and Mat'l. Report Oct 29 1948

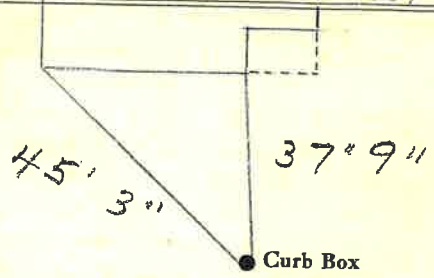

12" Main Elev. of Main at tap 5'

Gate at • Gate at

12' to main

• Curb Box

TAX ID # 302.12.2-19