


# LABOR AND MATERIALS

_____	Copper	} Connection	_____	\$	_____
_____	Lead				
_____	Curb	} Cock Valve T.S. & V.	_____ in.	\$	_____
_____	Service box		{ Short 3-1/2 x 4-1/2 } Old returned { Long 4-1/2 x 5-1/2 }	_____	\$
_____	Ft. _____ in.	{ Copper } { G.I. } { C.I. }		Pipe at _____	\$
_____	Nipples _____		in. at _____	\$	_____
_____	Bushings _____	to _____ in. at _____	\$	_____	
_____	Red'g				
_____	Inc'g				
_____	Union _____	in. at _____	\$	_____	
_____	Meter _____	in. at _____	\$	_____	
_____			\$	_____	
_____	Compound Joints at _____		\$	_____	
_____	Maintenance Foreman _____		\$	_____	
_____	Hrs. Water Maint. Man - 1 at _____		\$	_____	
_____	Hrs. Water Maint. Man - 2 at _____		\$	_____	
_____	Hrs. Garage Foreman _____	at _____	\$	_____	
_____	Hrs. Labor _____	at _____	\$	_____	
_____	Hrs. Compressor at _____		\$	_____	
_____			\$	_____	
_____	Trucking _____		\$	_____	
_____	Pav't Patch _____		\$	_____	
_____			\$	_____	
_____			\$	_____	
St. \_\_\_\_\_  
Pl. \_\_\_\_\_  
Ave. No. \_\_\_\_\_

Name of Owner  
90 WEBSTER

Labor and Mat'l. Report 19 \_\_\_\_\_

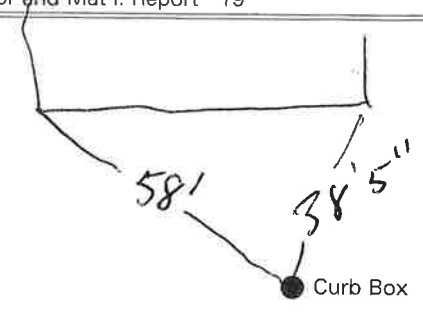

10 Main Elev. of Main at tap \_\_\_\_\_

Gate at ● Gate at ●

TAX ID # 302.12-2-20

● Curb Box